


D:\CAD PROJECTS\235 NORTHERN STAR RESOURCES LTD\23517 KCGM GROWTH PROJECT\03 DELIVERABLES\PRP\PD\AS BUILT\2000-F00-PFD-PR-10013.DWG 04-SEP-26 1:58PM ANNE HOYNE

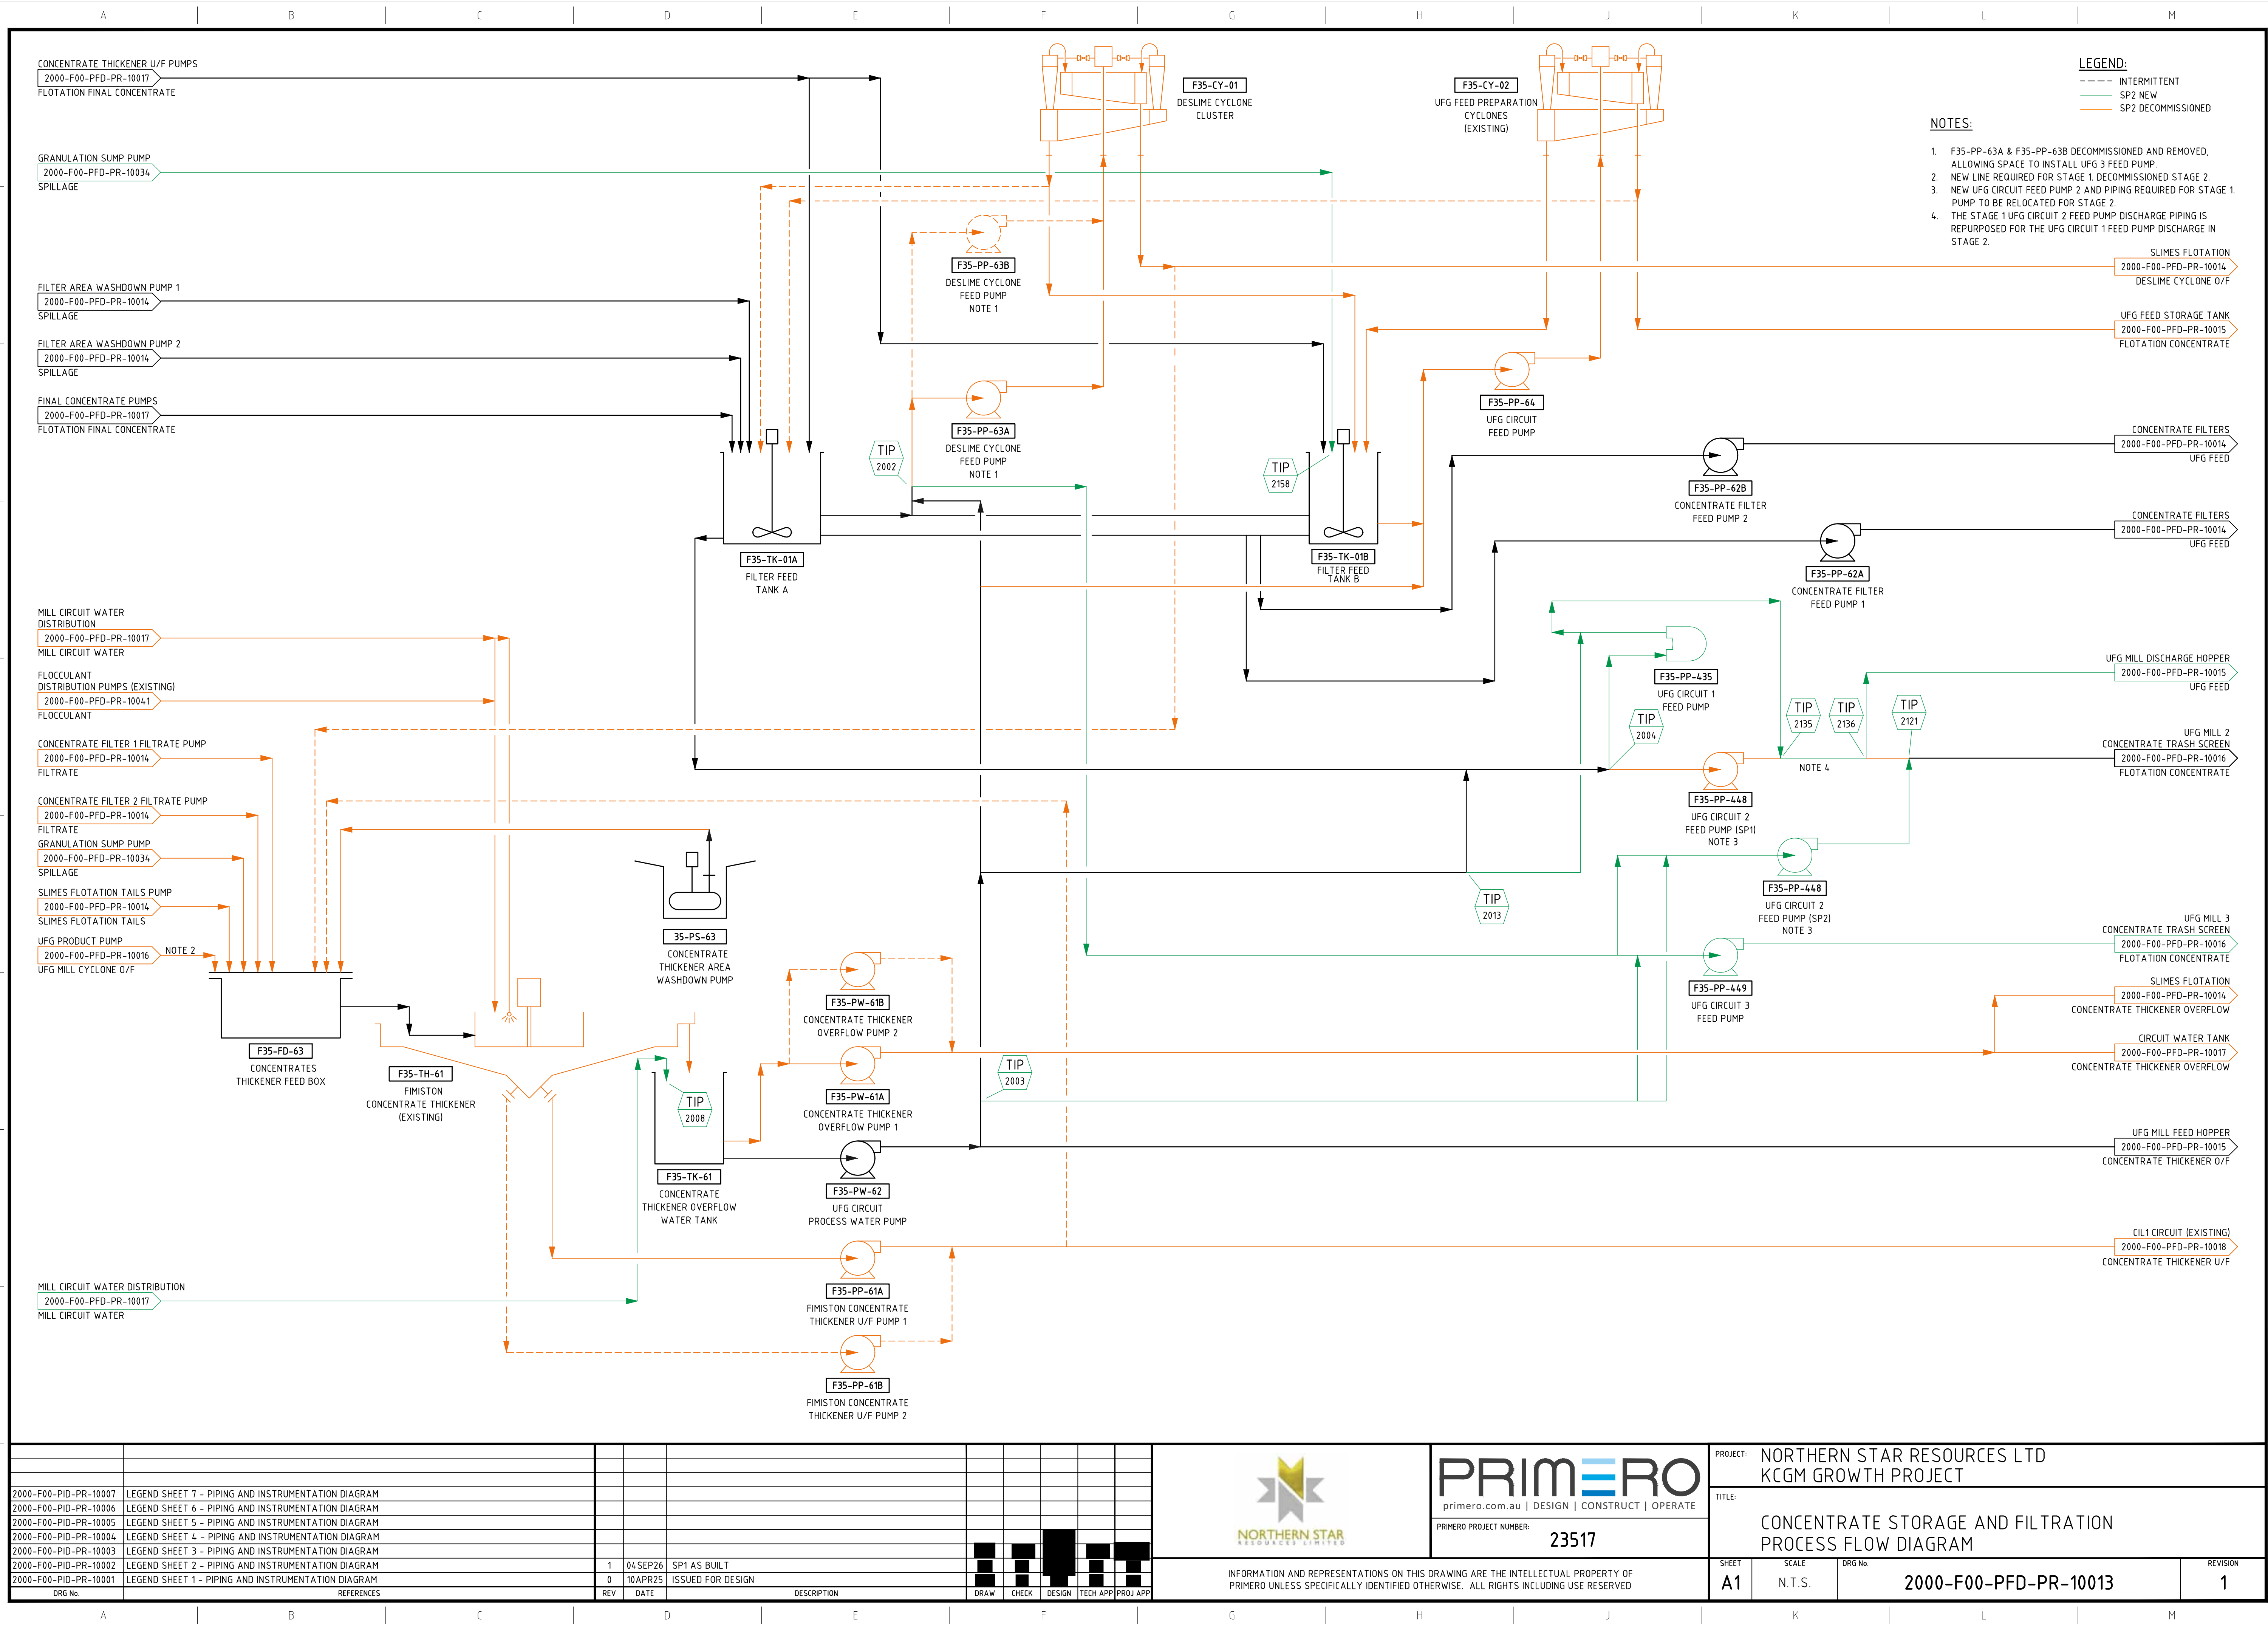

REV	DATE	DESCRIPTION	DRAW	CHECK	DESIGN	TECH APP	PROJ APP
1	04SEP26	SP1 AS BUILT					
0	10APR25	ISSUED FOR DESIGN					

LEGEND SHEET 7 - PIPING AND INSTRUMENTATION DIAGRAM	LEGEND SHEET 6 - PIPING AND INSTRUMENTATION DIAGRAM	LEGEND SHEET 5 - PIPING AND INSTRUMENTATION DIAGRAM	LEGEND SHEET 4 - PIPING AND INSTRUMENTATION DIAGRAM	LEGEND SHEET 3 - PIPING AND INSTRUMENTATION DIAGRAM	LEGEND SHEET 2 - PIPING AND INSTRUMENTATION DIAGRAM	LEGEND SHEET 1 - PIPING AND INSTRUMENTATION DIAGRAM
2000-F00-PID-PR-10007	2000-F00-PID-PR-10006	2000-F00-PID-PR-10005	2000-F00-PID-PR-10004	2000-F00-PID-PR-10003	2000-F00-PID-PR-10002	2000-F00-PID-PR-10001

ORG No.	REFERENCES



PRIMERO
primero.com.au | DESIGN | CONSTRUCT | OPERATE
PRIMERO PROJECT NUMBER: 23517

INFORMATION AND REPRESENTATIONS ON THIS DRAWING ARE THE INTELLECTUAL PROPERTY OF PRIMERO UNLESS SPECIFICALLY IDENTIFIED OTHERWISE. ALL RIGHTS INCLUDING USE RESERVED

PROJECT:	NORTHERN STAR RESOURCES LTD KCGM GROWTH PROJECT		
TITLE:	CONCENTRATE STORAGE AND FILTRATION PROCESS FLOW DIAGRAM		
SHEET	SCALE	DRG No.	REVISION
A1	N.T.S.	2000-F00-PFD-PR-10013	1