


D:\CAD PROJECTS\235 NORTHERN STAR RESOURCES LTD\23517 KCGM GROWTH PROJECT\03 DELIVERABLES\PR\PF\03 AS BUILT\2000-F00-PFD-PR-10021.DWG 07SEP26 11:36AM ANNE HOYNE

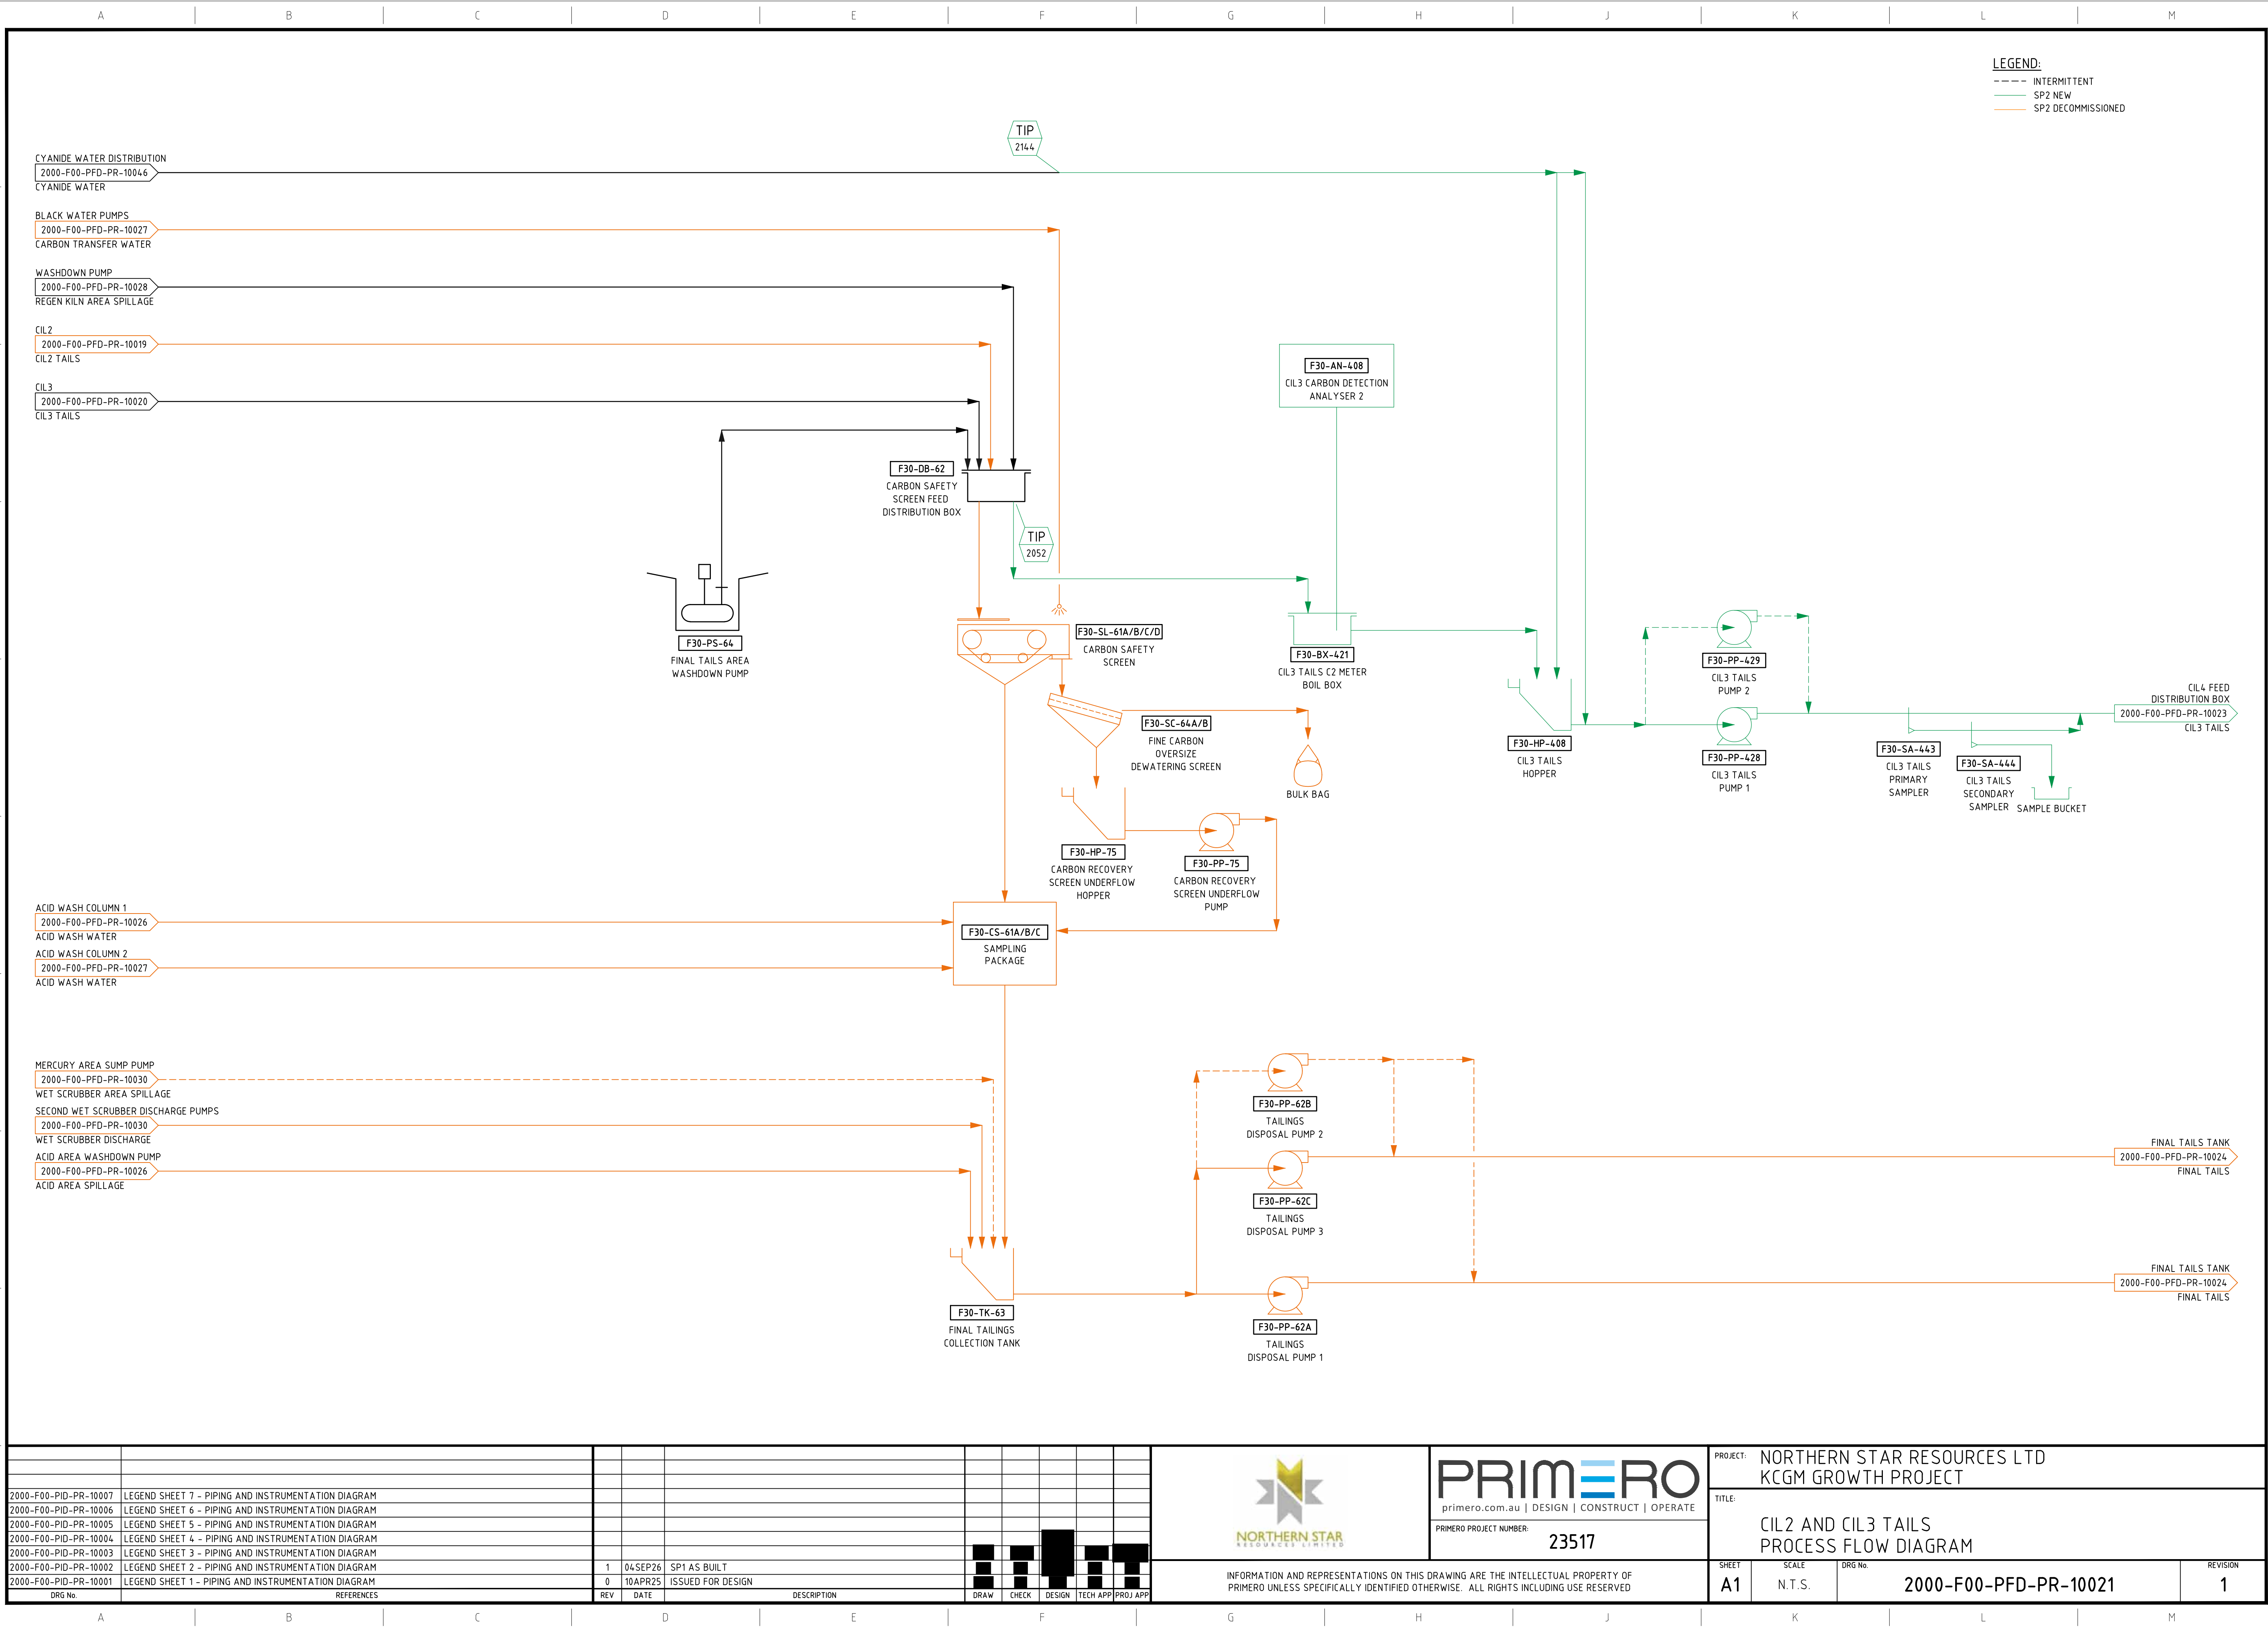

DRG No.	REFERENCES	REV	DATE	DESCRIPTION	DRAW	CHECK	DESIGN	TECH APP	PROJ APP
2000-F00-PID-PR-10007	LEGEND SHEET 7 - PIPING AND INSTRUMENTATION DIAGRAM								
2000-F00-PID-PR-10006	LEGEND SHEET 6 - PIPING AND INSTRUMENTATION DIAGRAM								
2000-F00-PID-PR-10005	LEGEND SHEET 5 - PIPING AND INSTRUMENTATION DIAGRAM								
2000-F00-PID-PR-10004	LEGEND SHEET 4 - PIPING AND INSTRUMENTATION DIAGRAM								
2000-F00-PID-PR-10003	LEGEND SHEET 3 - PIPING AND INSTRUMENTATION DIAGRAM								
2000-F00-PID-PR-10002	LEGEND SHEET 2 - PIPING AND INSTRUMENTATION DIAGRAM								
2000-F00-PID-PR-10001	LEGEND SHEET 1 - PIPING AND INSTRUMENTATION DIAGRAM								
		1	04SEP26	SP1 AS BUILT					
		0	10APR25	ISSUED FOR DESIGN					



PRIMERO PROJECT NUMBER:
23517

INFORMATION AND REPRESENTATIONS ON THIS DRAWING ARE THE INTELLECTUAL PROPERTY OF PRIMERO UNLESS SPECIFICALLY IDENTIFIED OTHERWISE. ALL RIGHTS INCLUDING USE RESERVED

PROJECT: NORTHERN STAR RESOURCES LTD KCGM GROWTH PROJECT			
TITLE: CIL2 AND CIL3 TAILS PROCESS FLOW DIAGRAM			
SHEET A1	SCALE N.T.S.	DRG No. 2000-F00-PFD-PR-10021	REVISION 1