


- NOTES:
- REFER TO 2000-F75-PID-PR-25008 FOR FINAL TAILS SLURRY LINES RE-ROUTING.

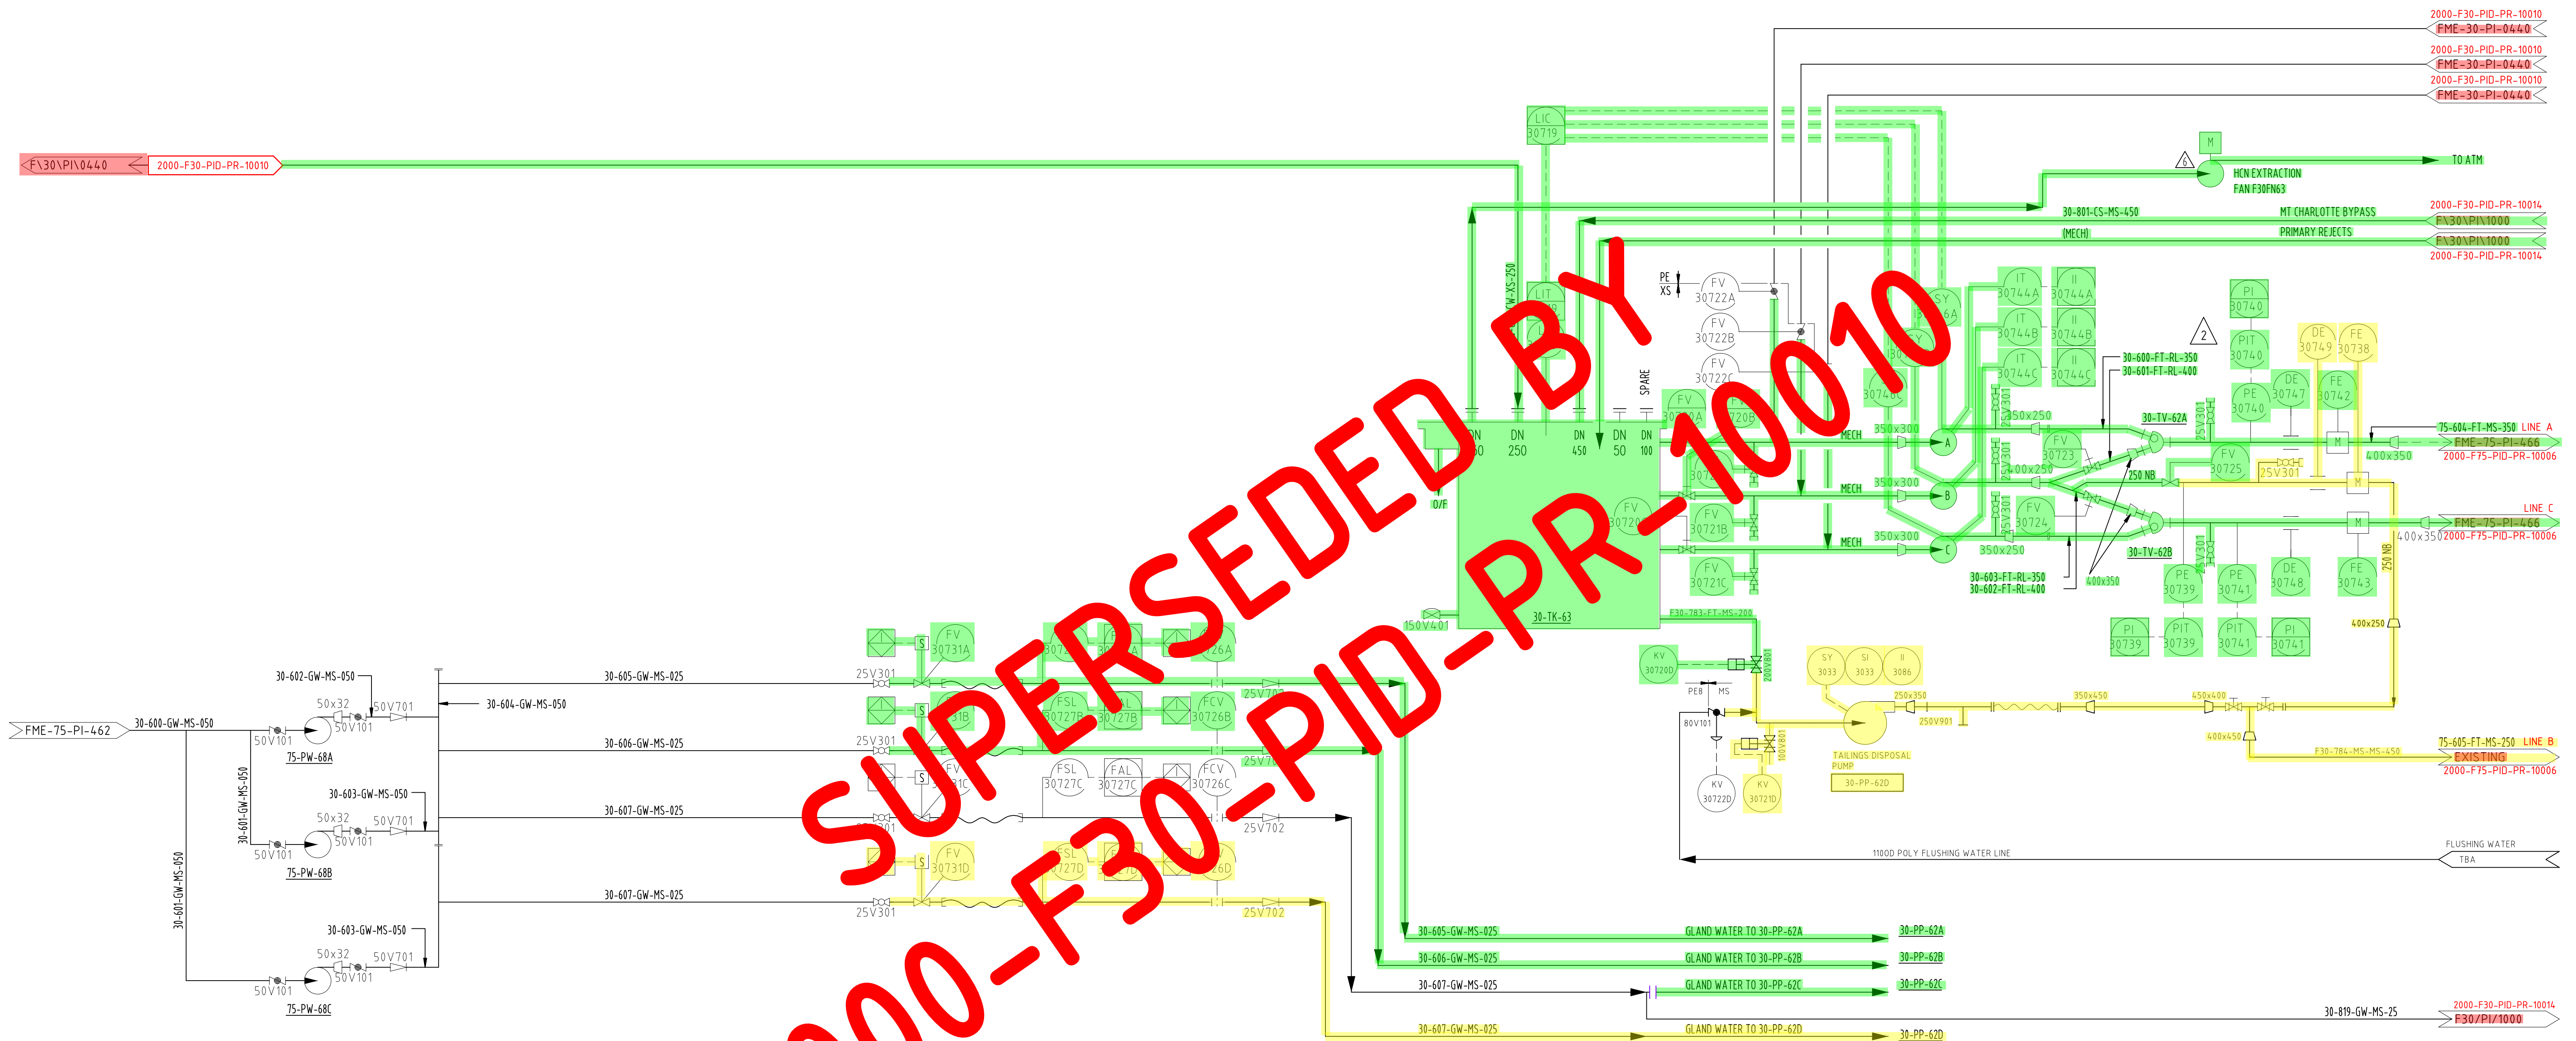

LEGEND				
—	STAGE 1 - NEW			
—	STAGE 1 - REMOVE			
—	STAGE 1 - DECOMMISSIONED (OTHERS)			
—	STAGE 2 - NEW			
—	STAGE 2 - REMOVE			
—	STAGE 2 - DECOMMISSIONED (OTHERS)			

KCGM GROWTH PROJECT				
DRAWING NO. 2000-F30-PID-PR-10015				
E	11FEB25	SUPERSEDED	LV	DM
D	30MAY24	ISSUED FOR HAZOP	LV	DM
C	26APR24	ISSUED FOR DESIGN	LV	DM
B	01MAR24	ISSUED FOR CLIENT REVIEW	LV	DM
REV	DATE	DESCRIPTION	CHECK	TECH APP

DRAWING No.		REFERENCE DRAWINGS
-------------	--	--------------------

COPYRIGHT ©
This drawing remains the property of MINPROC ENGINEERS LIMITED and may not be copied in any way without prior written approval from this company.

MINPROC ENGINEERS LIMITED

A.C.N. 008 992 694
22, STIRLING HIGHWAY, NEDLANDS WA 6009
PHONE (09) 347 4777

7	PAZ	19/03/20	AS BUILT	T.R.		0	PAZ	17/3/95	AS-BUILT	T.R.	
No.	BY	DATE	REVISION	CHECKED	APPROV.	No.	BY	DATE	REVISION	CHECKED	APPROV.

PROJECT APPR.	BY ML	DATE 6/5/95
DESIGN APPR.	DT	5/5/95
DESIGNED	GT	5/5/95
CHECKED	PGN	20/4/95
DRAWN	SDB	19/7/94

CLIENT
KALGOORLIE CONSOLIDATED GOLD MINES

TITLE
FIMISTON EXPANSION 1994/95
PIPING & INSTRUMENTATION DIAGRAM
CARBON SAFETY SCREENS

SIZE
B1

SCALE
N.T.S.

REV. 0

DRAWING No.
FME-30-PI-1011