


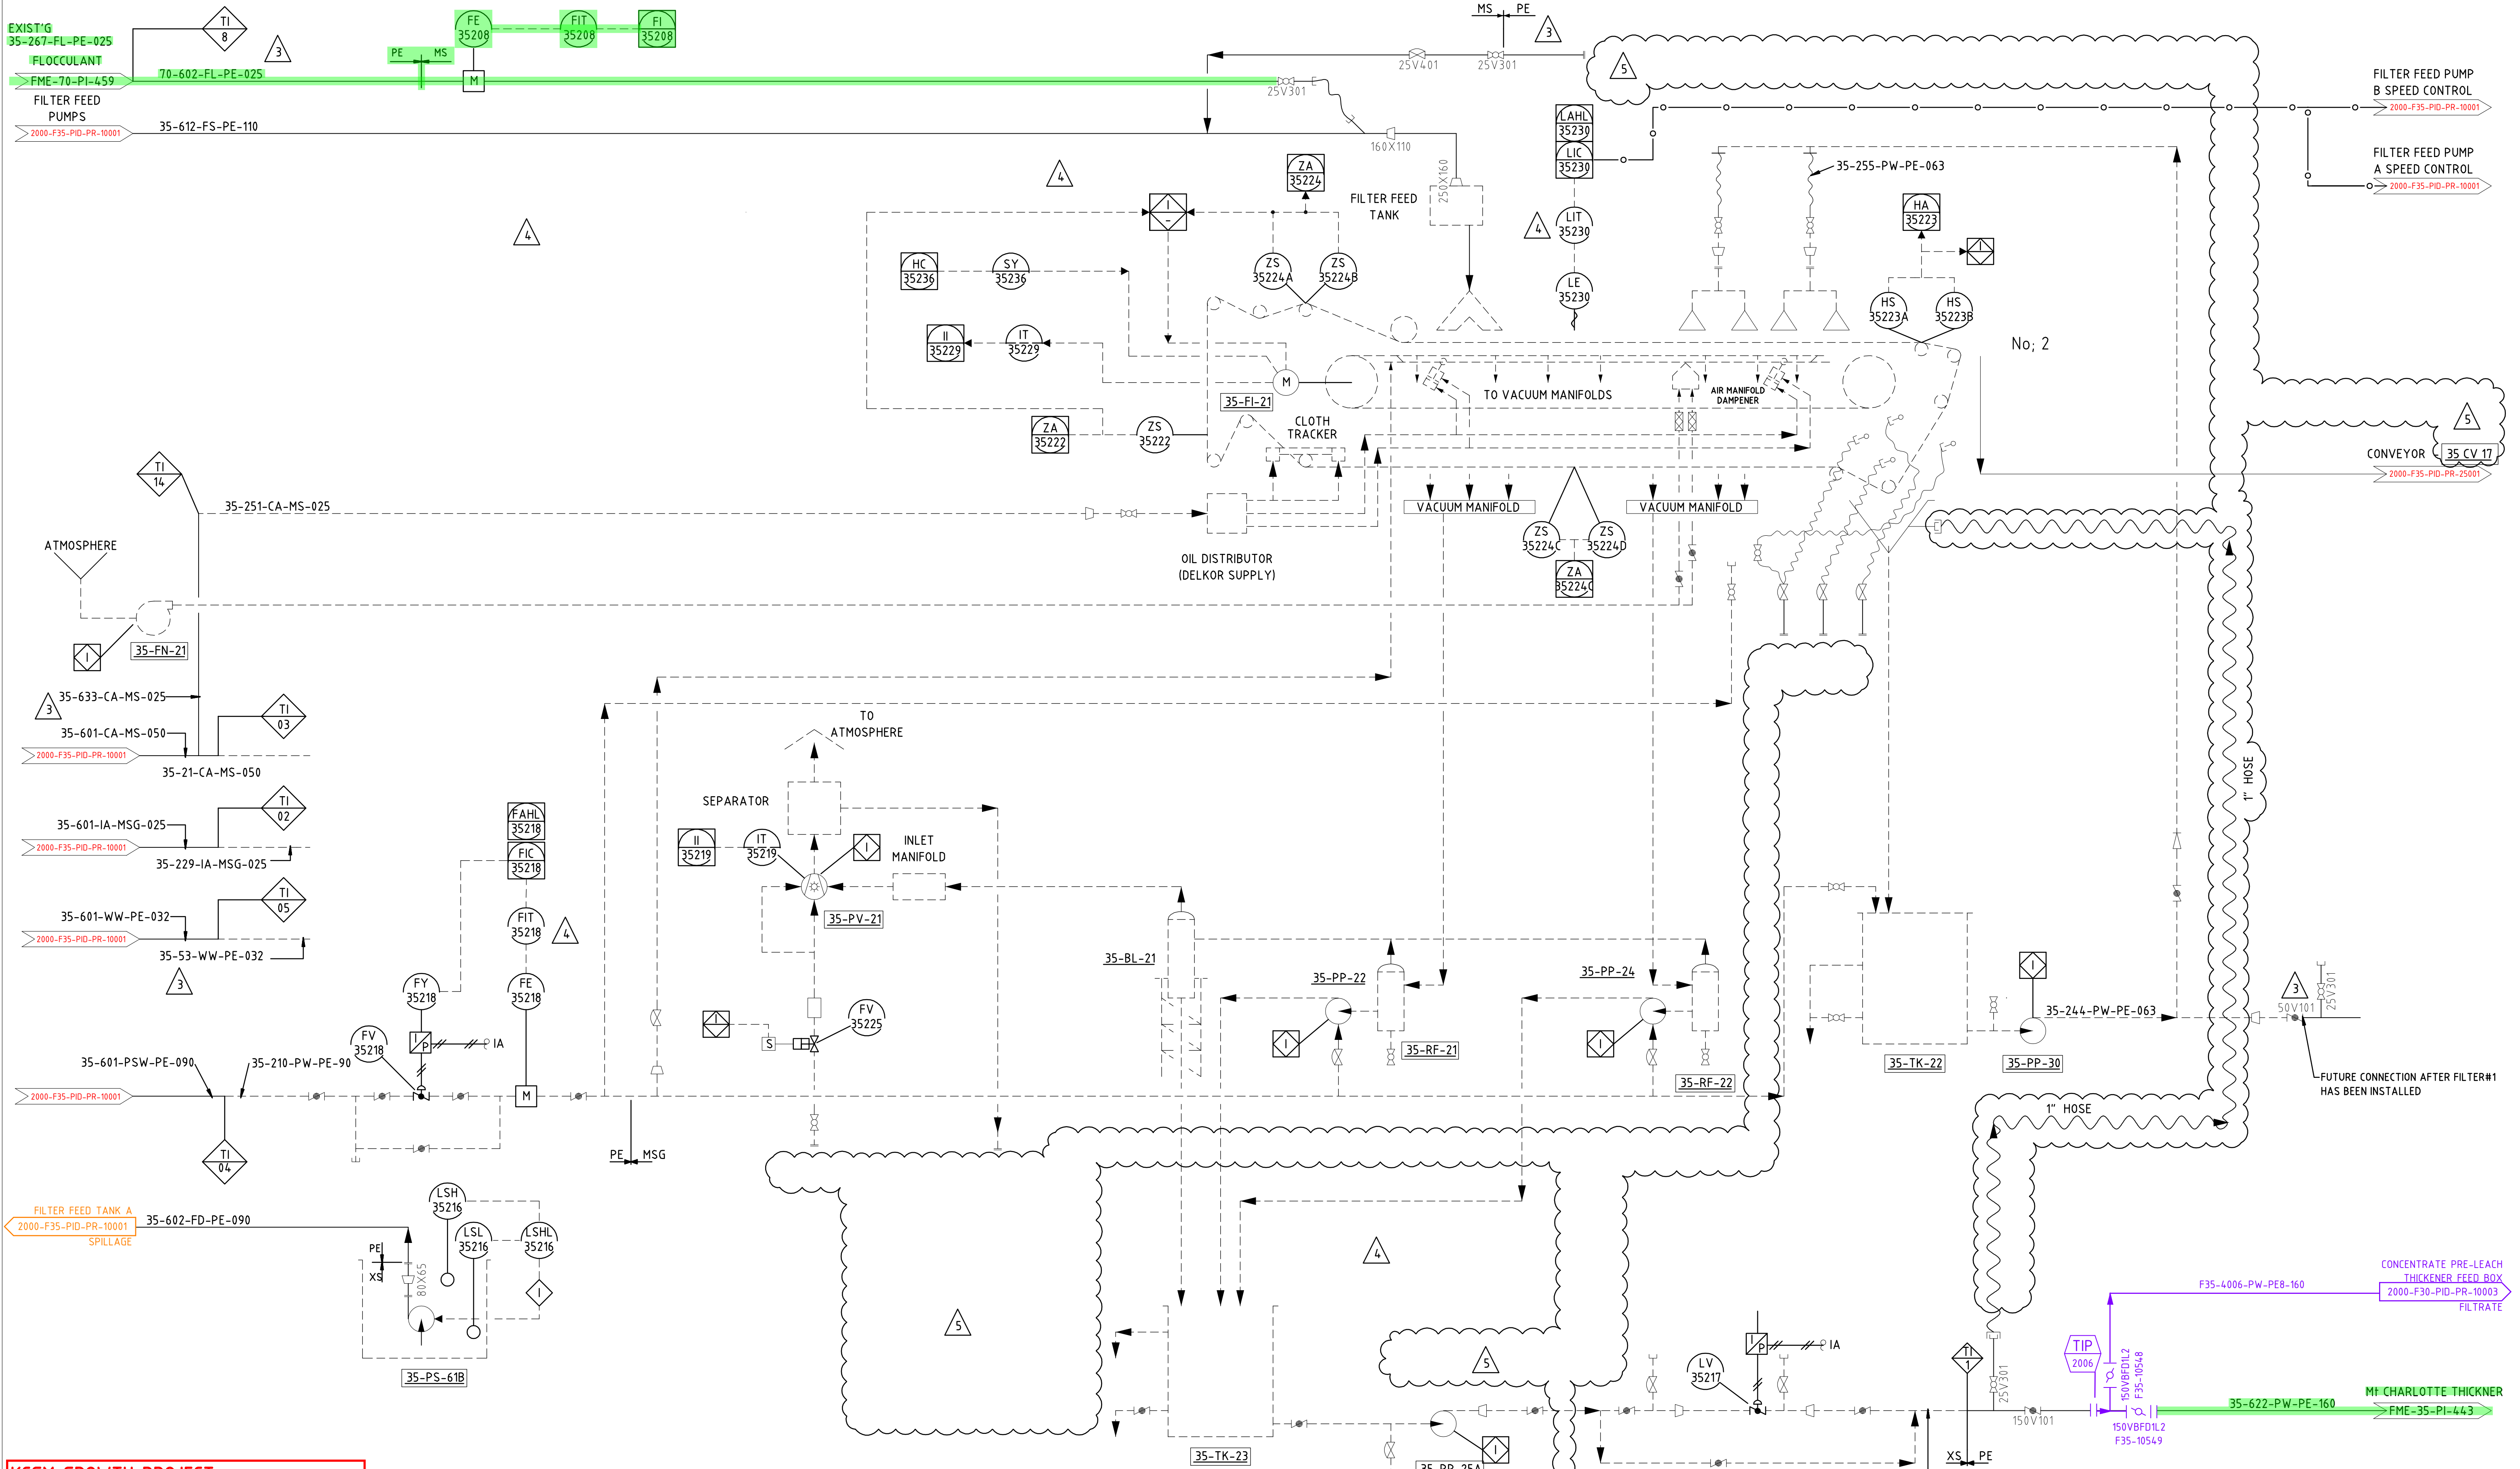

KCGM GROWTH PROJECT				
DRAWING NO. 2000-F35-PID-PR-10005				
1	4SEP25	UPDATED 35-PS61B DISCHARGE	LV	DM
0	25JUN25	APPROVED FOR CONSTRUCTION	LV	DM
REV	DATE	DESCRIPTION	CHECK	TECH APP

COPYRIGHT ©				
This drawing remains the property of MINPROC ENGINEERS LIMITED and may not be copied in any way without prior written approval from this company.				

MINPROC ENGINEERS LIMITED

A.C.N. 008 992 694
22, STIRLING HIGHWAY, NEDLANDS WA 6009
PHONE (09) 347 4777

5	LW	30.04.2020	PUMP & TANK REMO'D. - 'AS BUILT'.	GT	GT
4	FW	30/11/94	REVISED AS NOTED SEE DWG SP-410		
3	PR	8/11/94	REVISED AS NOTED SEE DWG SP-410	GT	
2	PR	31/10/94	APPROVED FOR CONSTRUCTION	GT	
1	GT	25/10/94	ISSUED FOR MAT'L TAKE-OFF	GT	
0	PR	12/09/94	APPROVED FOR TENDER	GT	
No.	BY	DATE	REVISION	CHECKED	APPROV.

CLIENT	KALGOORLIE CONSOLIDATED GOLD MINES		SIZE	SCALE
TITLE	FIMISTON EXPANSION 1994/95 PIPING & INSTRUMENTATION DIAGRAM CONCENTRATE FILTER BELT No2		REV. No.	N.T.S.
DRAWING No.	FME-35-PI-446		REV. No.	0112131415