


- NOTES
1. DELETED.
 2. XXX REFERS TO PROCESS SLURRY CONTAINING MERCURY
 3. NEW 160 OD HDPE LINE TO REPLACE EXISTING LINE TO TAIL'S DISCHARGE HOPPER

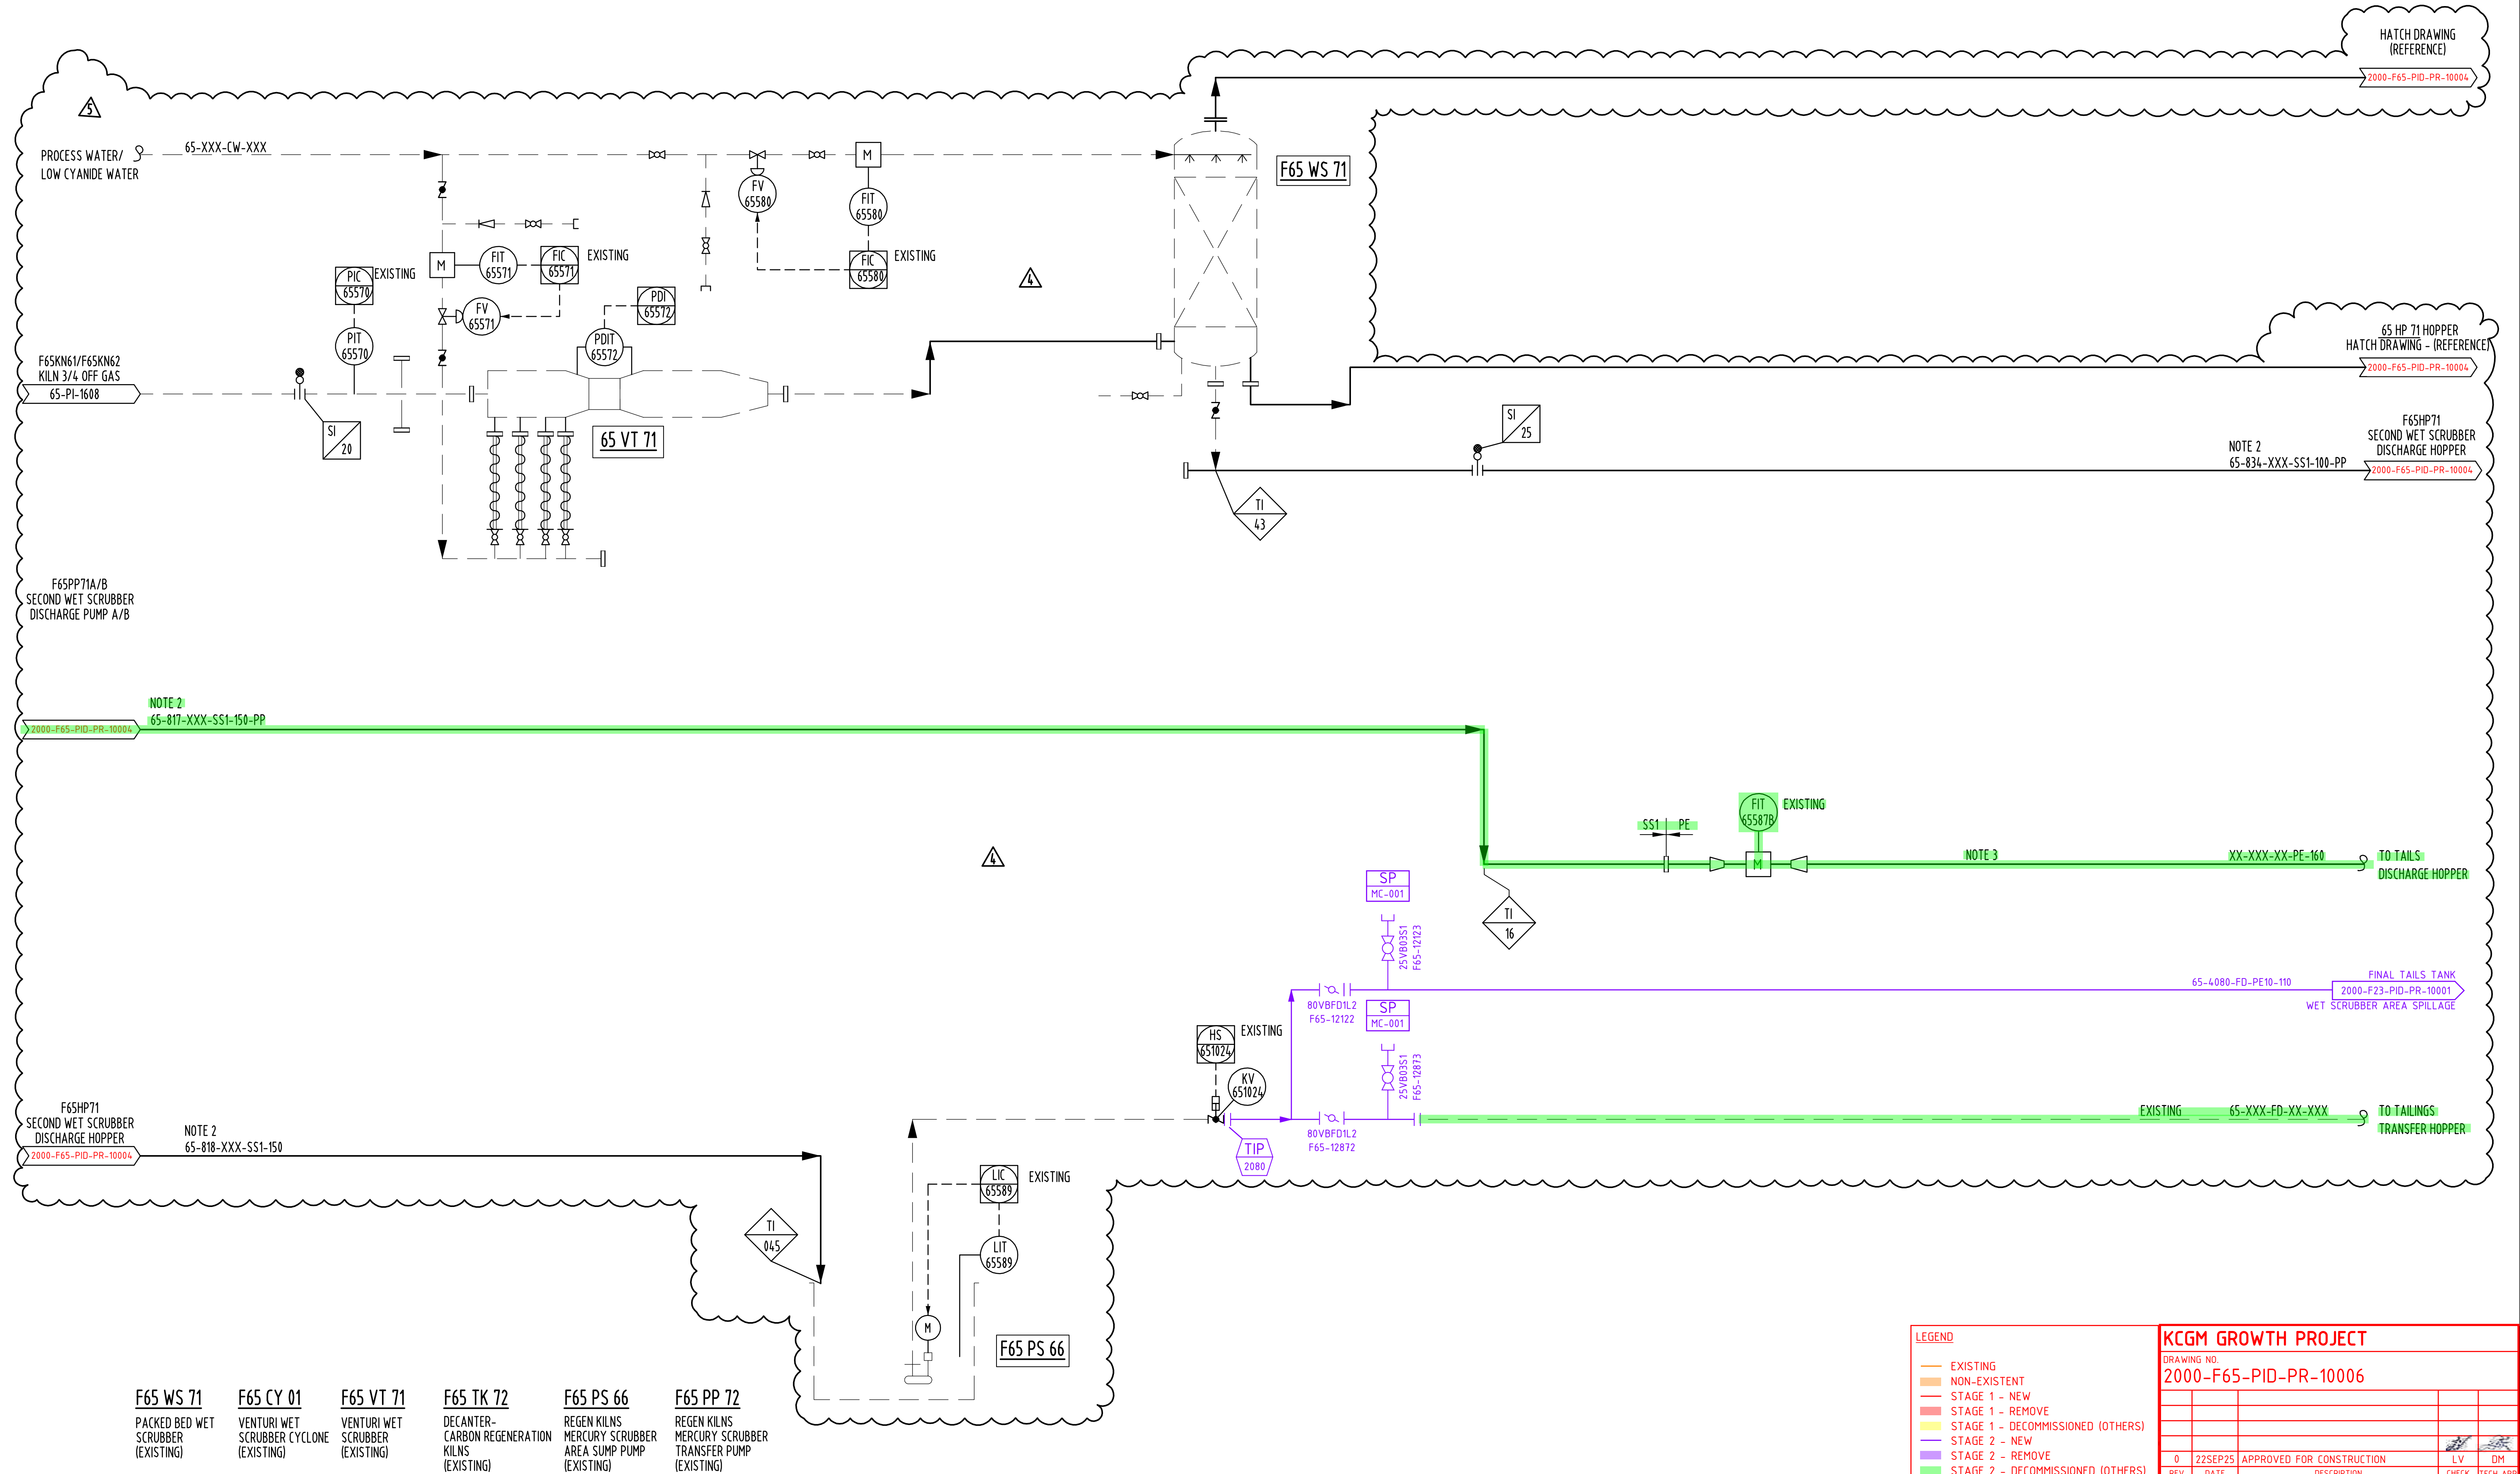

						5	17.04.2020	REVISED - "AS BUILT"		L.W.	T.R.	-				SCALE		NTS		
						4	05.05.2016	AS BUILT ADDED		OGS						DRAWN	EL	24.JUN13		
						3	06MAR15	REVISED FOR GAS SUBMISSION		JR	MDR	JMD				DESIGNED	CJR	24.JUN13		
						2	28NOV14	GENERAL REVISION		RAM	YA	JMD	ABBREVIATIONS, DRAWING EQUIPMENT NUMBERING & BASIC VALVE SYMBOLS	04 \ SP \ 1003		CHECKED	YA	24.JUN13		
						1	12SEP14	ISSUED FOR CONSTRUCTION		JG	YA	JM	TYPICAL DETAILS - PIPING AND INSTRUMENTATION DIAGRAM SHEET 2	00-PI-1603		APPROVED	TB	24.JUN13		
						0	23MAY14	ISSUED FOR DESIGN		CE	YA	TB	TYPICAL DETAILS - PIPING AND INSTRUMENTATION DIAGRAM SHEET 1	00-PI-1602		PROJ APP				
MYK	DATE		REVISION		BY	CKD	APP	MYK	DATE		REVISION		BY	CKD	APP	REFERENCE DRAWINGS	DWG NO.	PROJ. FILE #		