


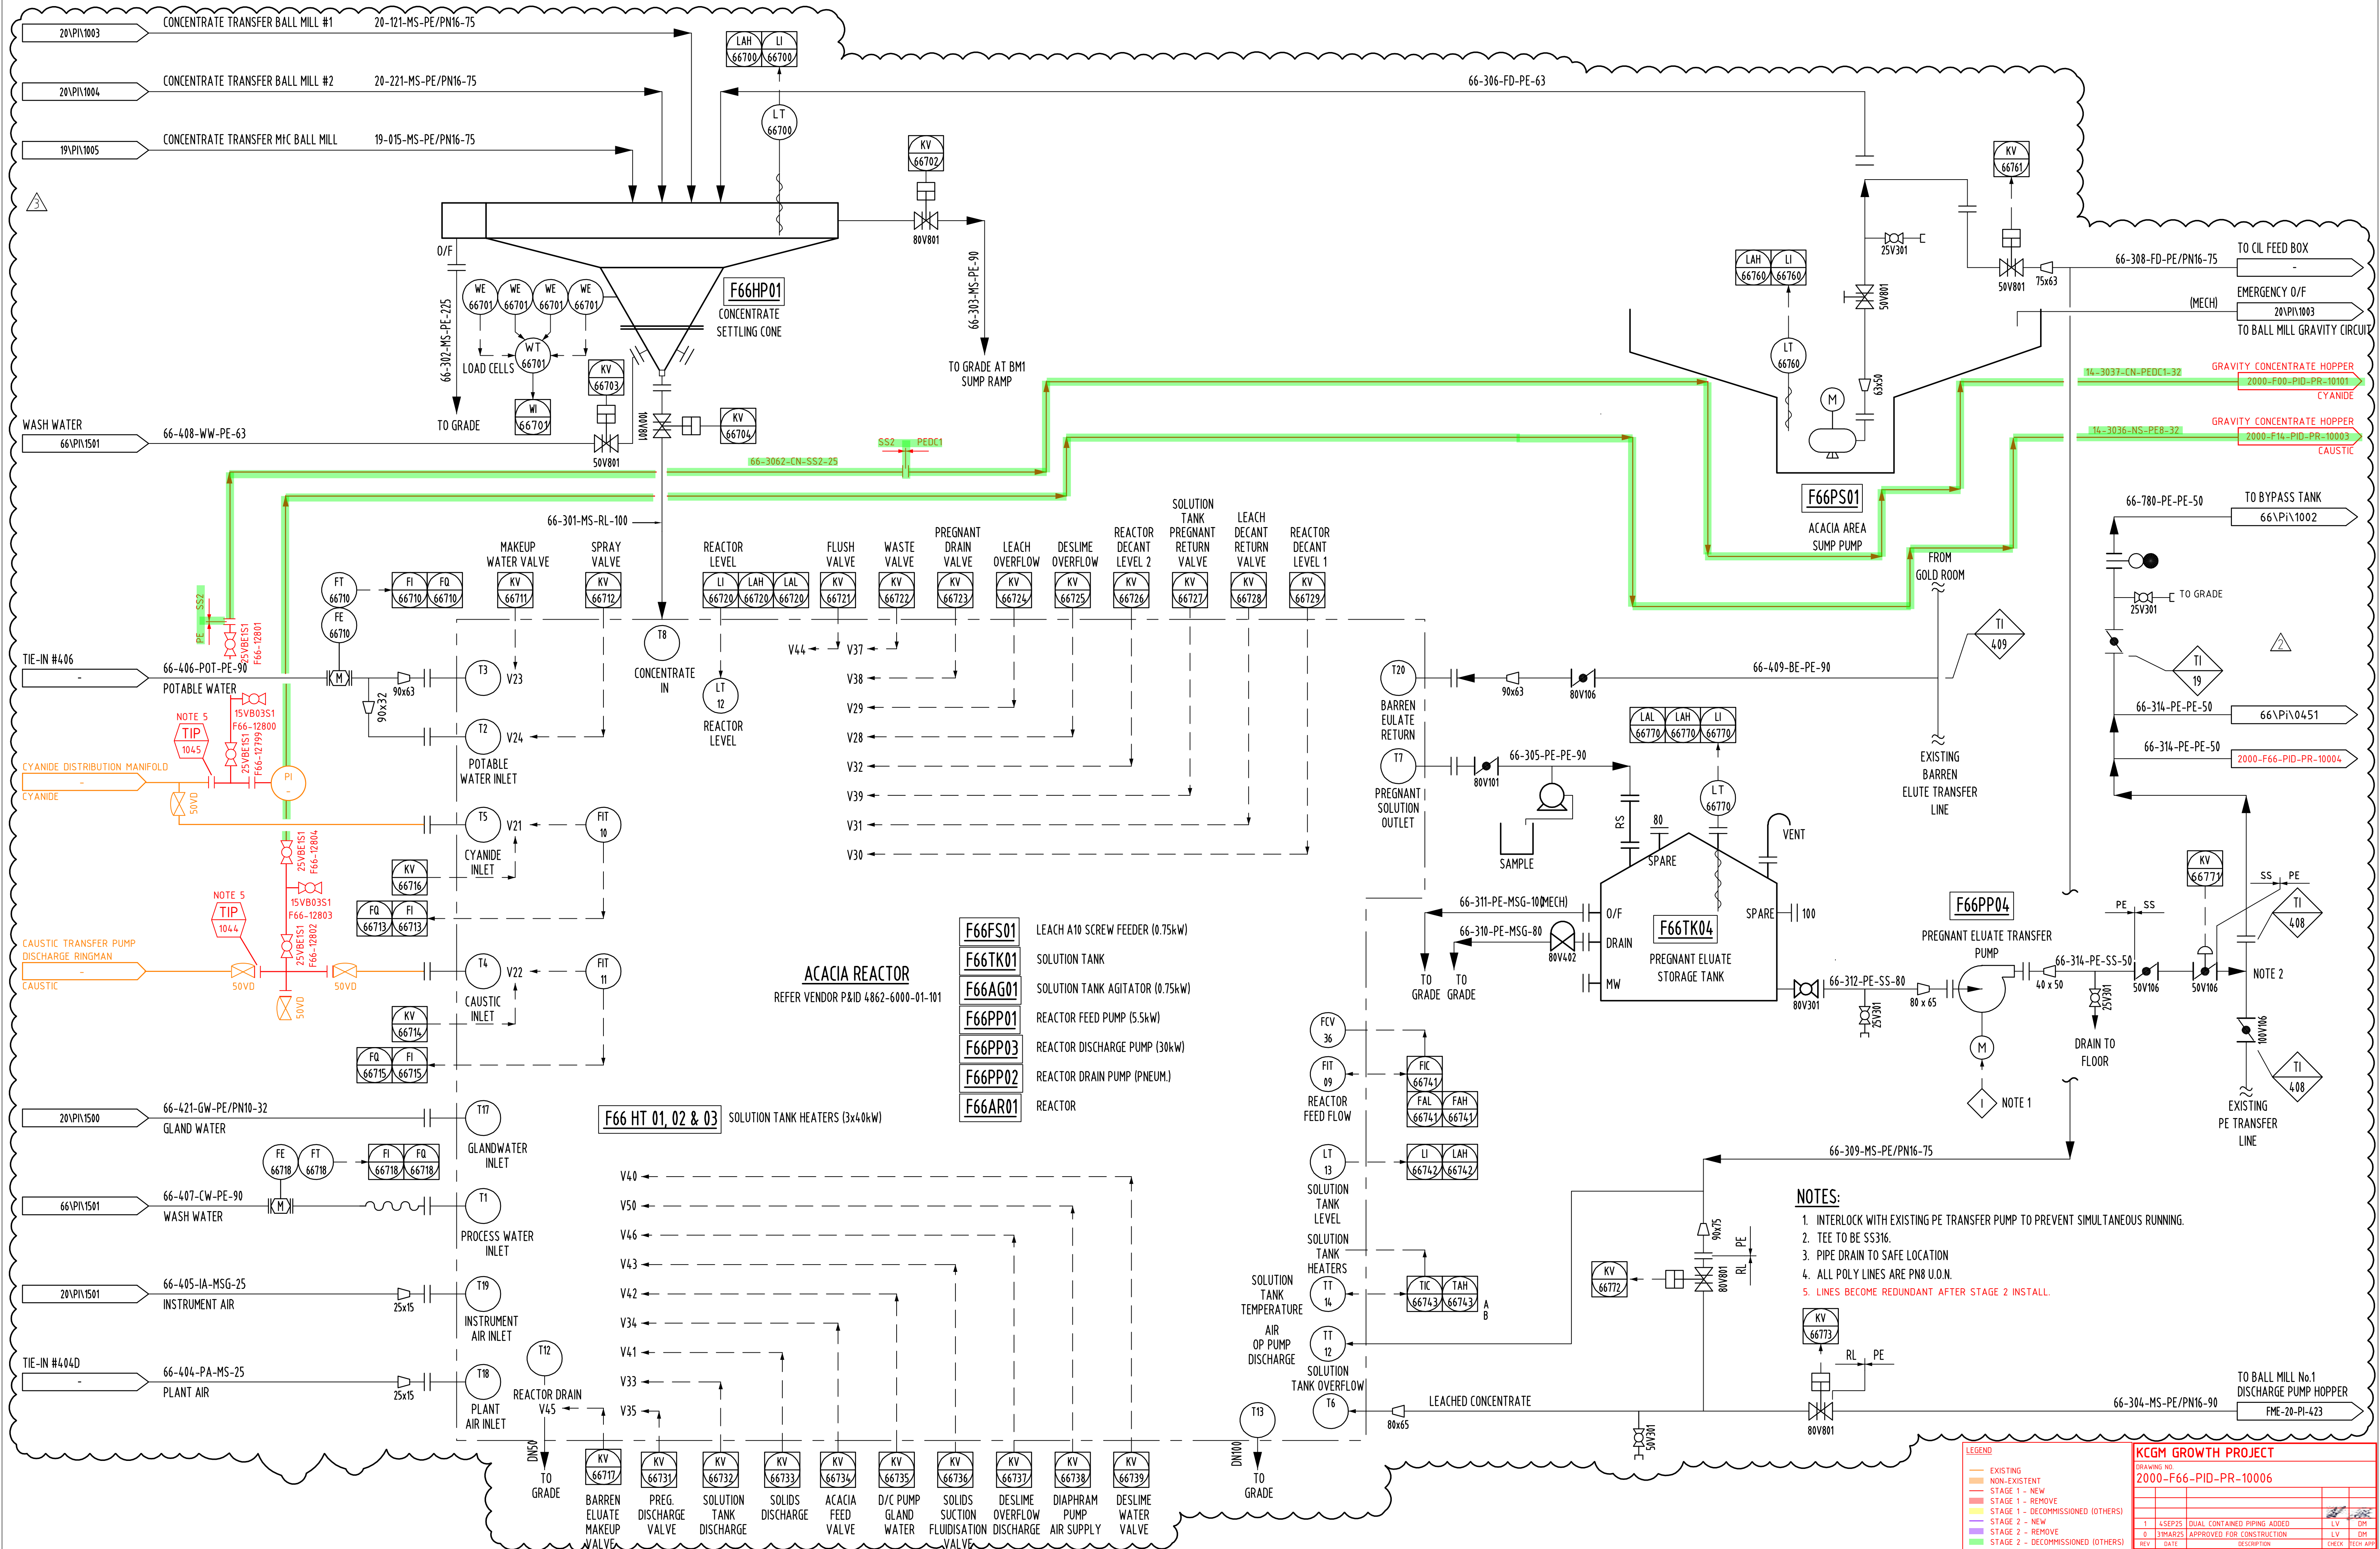

SCALE			NTS			FIMSTON PLANT GRAVITY CIRCUIT ACACIA REACTOR AREA P & ID			SIZE			DRAWING NUMBER			REV		
DRAWN			WORLEY			1/12/03			A1			66\PI\1500			3		
DESIGNED			WORLEY			1/12/03											
CHECKED			WORLEY			1/12/03											
APPROVED			WORLEY			1/12/03											
PROJ APP																	
DWG NO.																	
PROJ FILE #																	
REFERENCE DRAWINGS																	
BY			L.W.			T.R.											
CKD			AKU			SRM											
APP			LB			AJL			ACH								
REVISION			REVISION			REVISION			REVISION			REVISION			REVISION		
BY			BY			BY			BY			BY			BY		
CKD			CKD			CKD			CKD			CKD			CKD		
APP			APP			APP			APP			APP			APP		
DATE			DATE			DATE			DATE			DATE			DATE		
3			30.04.2020			REVISED - 'AS BUILT'											
2			05.07.2016			ISSUED FOR ELUATE BYPASS TANK TENDER											
1			15.06.2016			ELUATE BYPASS TANK ADDED											
0			12.05.04			APPROVED FOR CONSTRUCTION											