
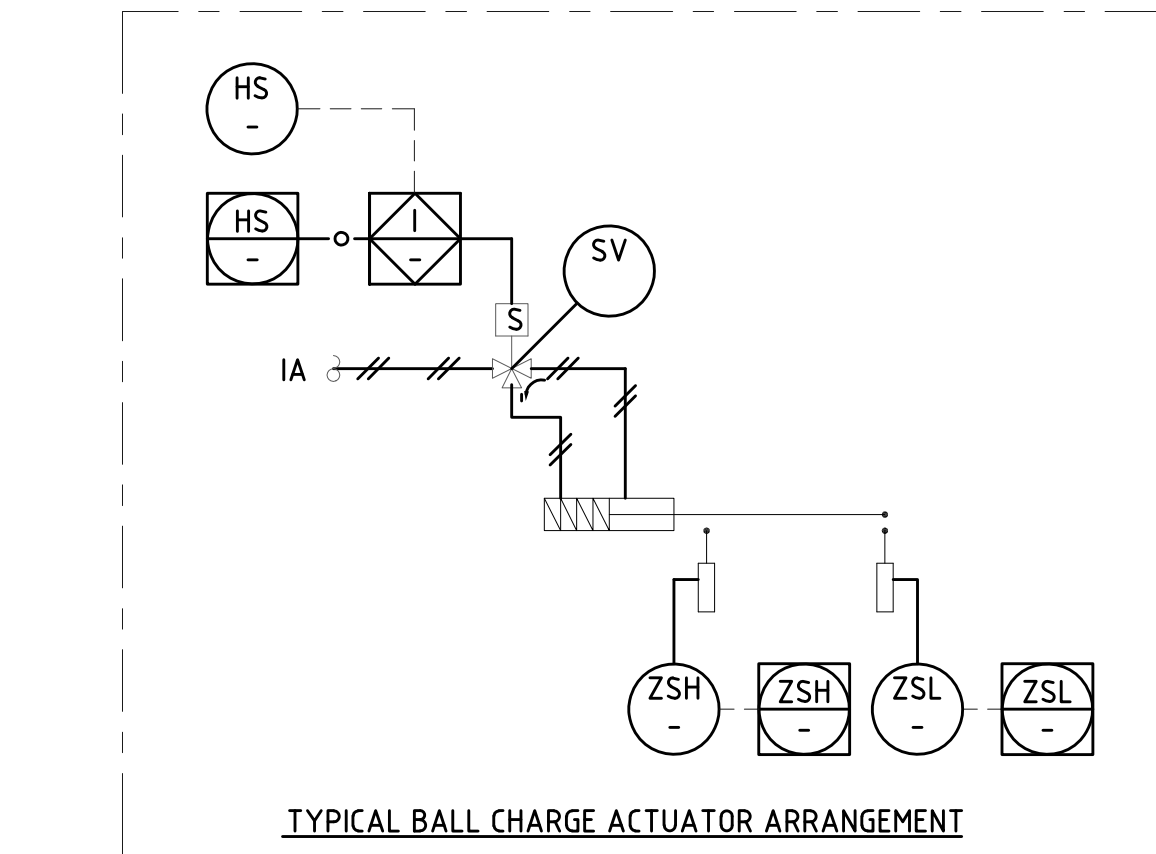


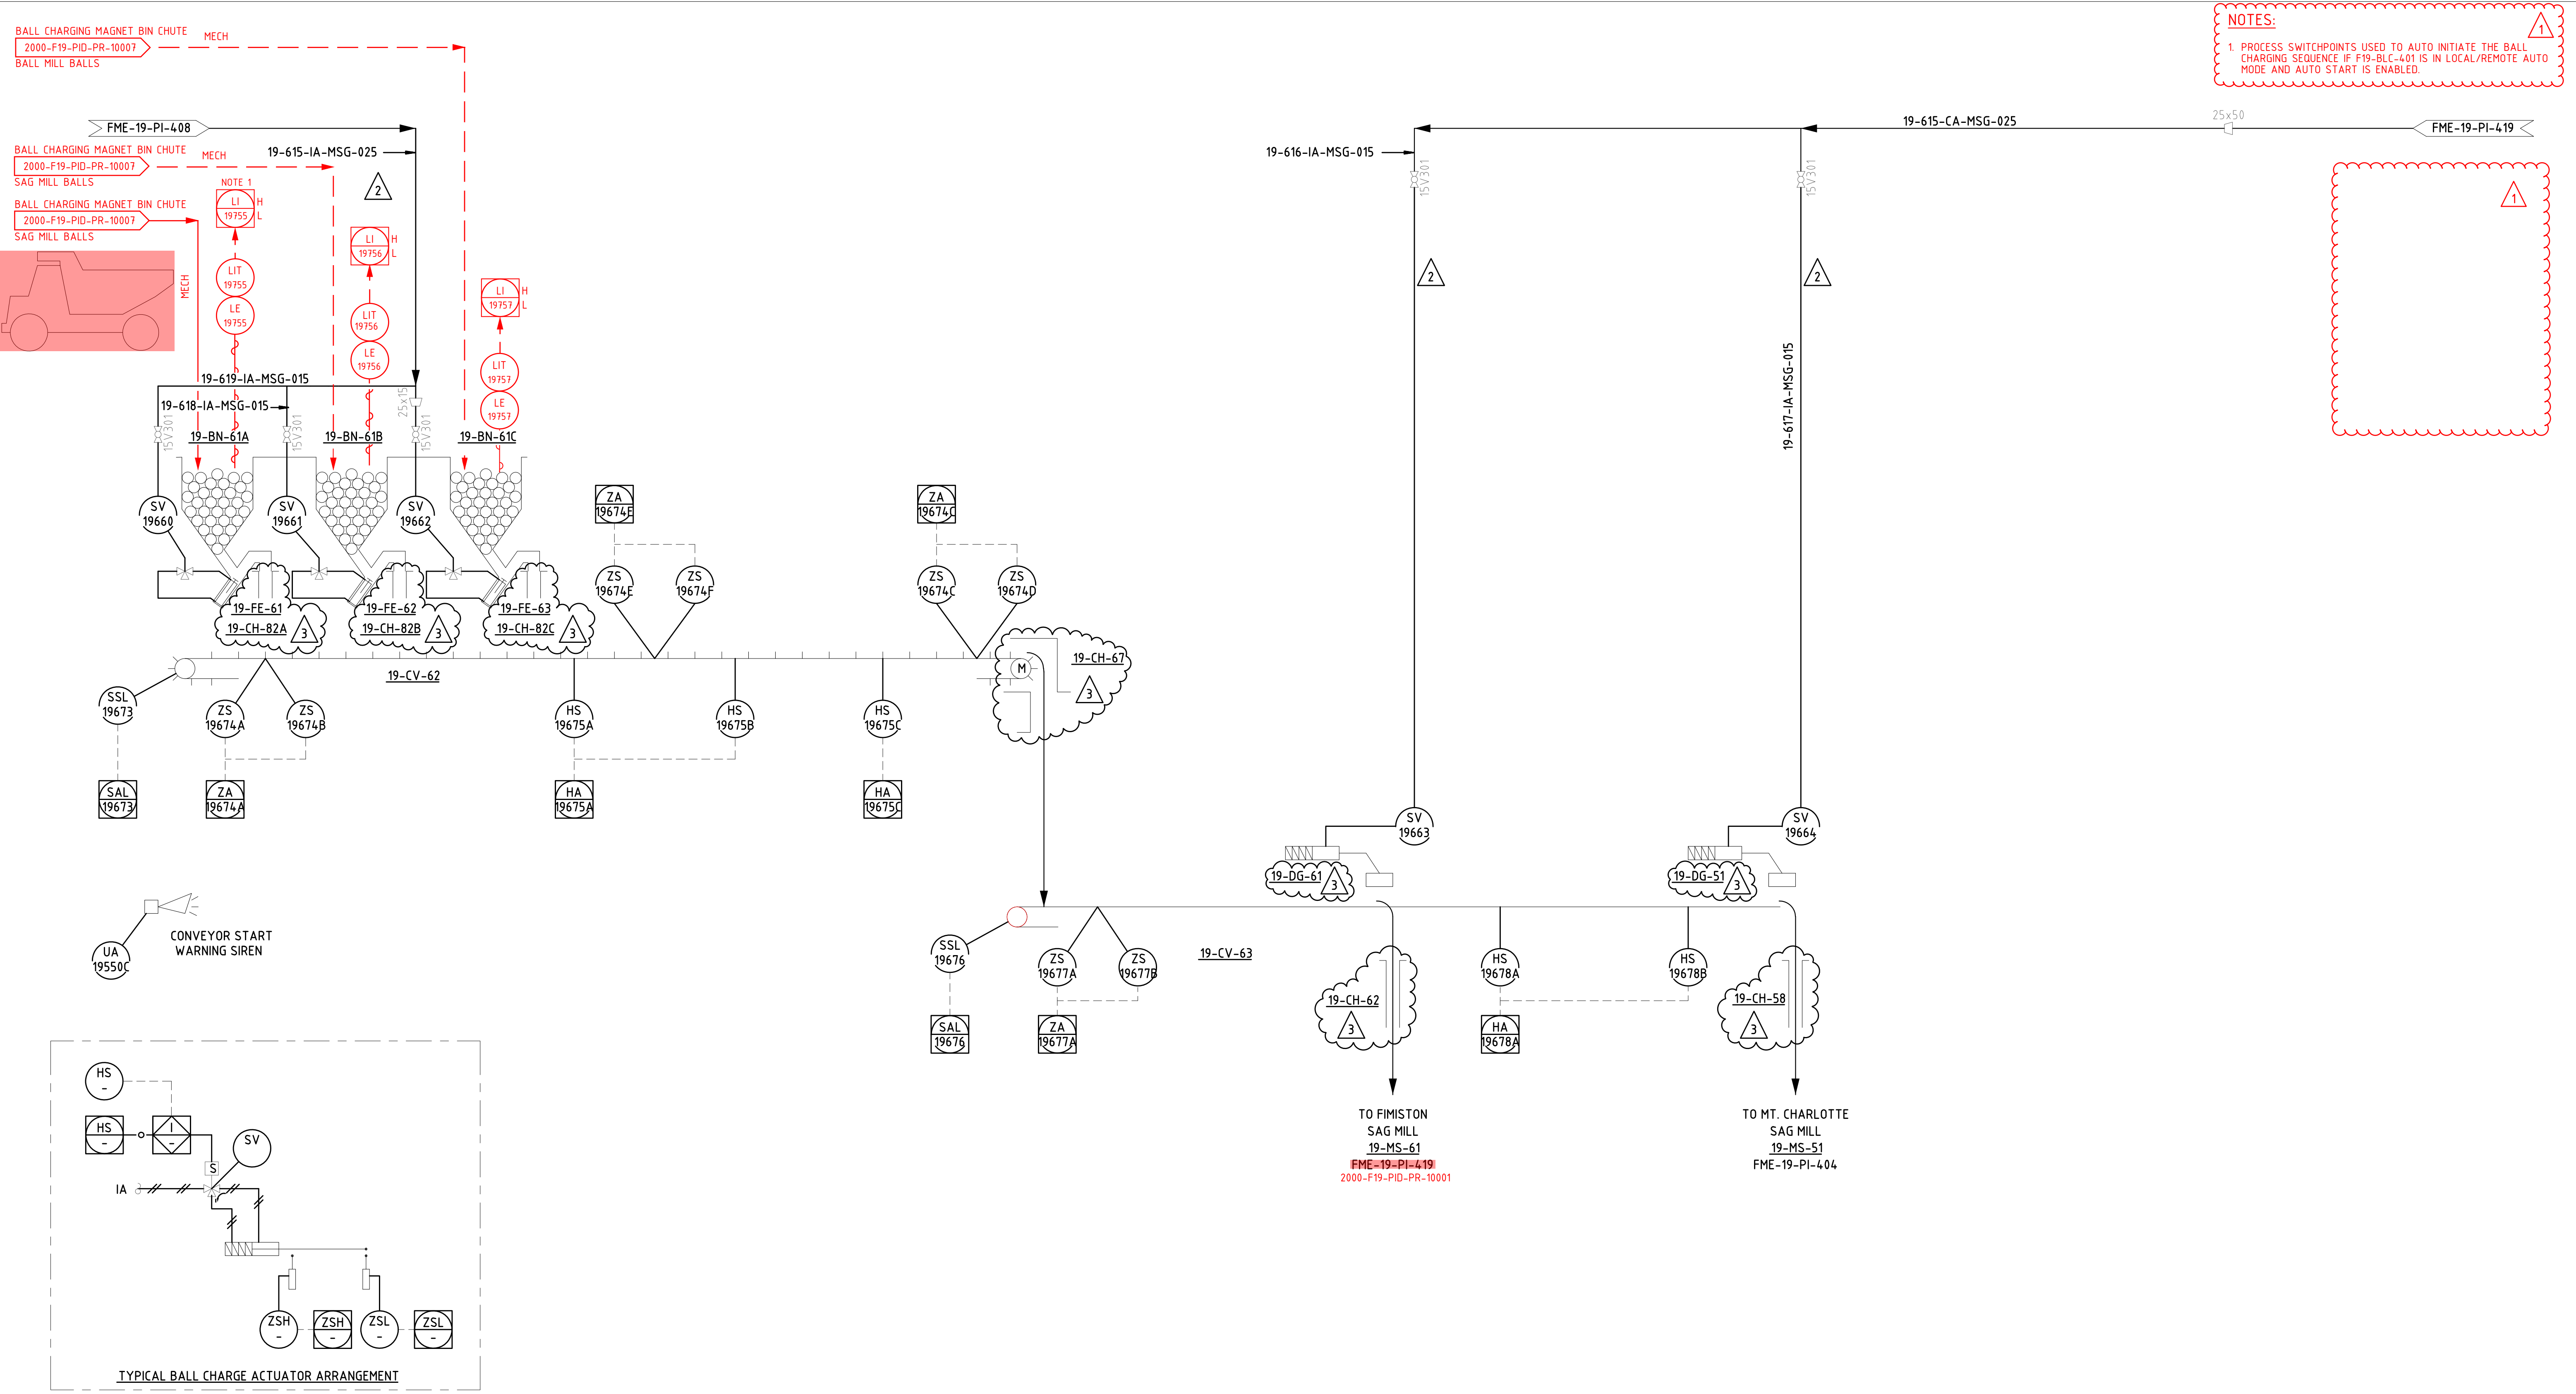

- 19-CH-82A CONVEYOR CV62 FEED CHUTE No. 1
- 19-CH-82B CONVEYOR CV62 FEED CHUTE No. 2
- 19-CH-82C CONVEYOR CV62 FEED CHUTE No. 3
- 19-BN-61A BALL CHARGING BIN No. 1
- 19-BN-61B BALL CHARGING BIN No. 2
- 19-BN-61C BALL CHARGING BIN No. 3
- 19-CV-62 BALL CHARGE CONVEYOR No. 1

- 19-FE-61 BALL FEEDER No. 1
- 19-FE-62 BALL FEEDER No. 2
- 19-FE-63 BALL FEEDER No. 3
- 19-CH-67 CONVEYOR CV62 HEAD CHUTE

- 19-CH-62 FIMISTON SAG MILL BALL FEED CHUTE
- 19-CH-58 MT. CHARLOTTE SAG MILL BALL FEED CHUTE
- 19-CH-74 CONVEYOR CV63 HEAD CHUTE
- 19-CV-63 BALL CHARGE CONVEYOR No. 2

- 19-DG-51 MT CHARLOTTE SAG MILL DIVERTER GATE
- 19-DG-61 FIMISTON SAG MILL DIVERTER GATE

KCGM GROWTH PROJECT					
DRAWING NO. 2000-F19-PID-PR-10006					
1	09SEP24	ISSUED FOR PROCESS CONTROL REVIEW	JDM	EW	
0	05SEP23	APPROVED FOR CONSTRUCTION	RB	LV	
REV	DATE	DESCRIPTION	CHECK	TECH APP	

CLIENT APPROVED for CONSTRUCTION
DATE:10/3/95 SIGNED: J.WILTSHIRE

FME-00-SP-408	INSTRUMENT STANDARDS
FME-00-SP-404	ABBREV & VALVE SYMBOLS
FME-00-SP-403	STANDARD EQUIPMENT SYMBOLS
DRAWING No.	REFERENCE DRAWINGS

COPYRIGHT ©
This drawing remains the property of MINPROC ENGINEERS LIMITED and may not be copied in any way without prior written approval from this company.

MINPROC ENGINEERS LIMITED

A.C.N. 008 992 694
22, STIRLING HIGHWAY, NEDLANDS WA 6009
PHONE (09) 347 4777

No.	BY	DATE	REVISION	CHECKED	APPROV.	No.	BY	DATE	REVISION	CHECKED	APPROV.
4	PAZ	02/01/20	AS BUILT	T.R.	P.A.	3	PR	3/5/95	REVISED AS NOTED	G.T	D.T
2	PR	31/3/95	REVISED AS NOTED	G.T	D.T	1	SB	10/2/95	APPROVED FOR CONSTRUCTION	G.T	D.T
0	SB	09/01/95	APPROVED FOR TENDER								

PROJECT APPR.	BY D.MARSHALL	DATE 9/3/95
DESIGN APPR.	D.TAYLOR	3/5/95
DESIGNED	D.TURNER	20/2/95
CHECKED	G.TORKINGTON	28/2/95
DRAWN	P.R	10-08-94

KALGOORLIE CONSOLIDATED GOLD MINES

FIMISTON EXPANSION 1994/95
PIPING & INSTRUMENT DIAGRAM
BALL CHARGING SYSTEM

SIZE B1

SCALE N.T.S.

REV: 01121314

DRAWING No. FME-19-PI-422