


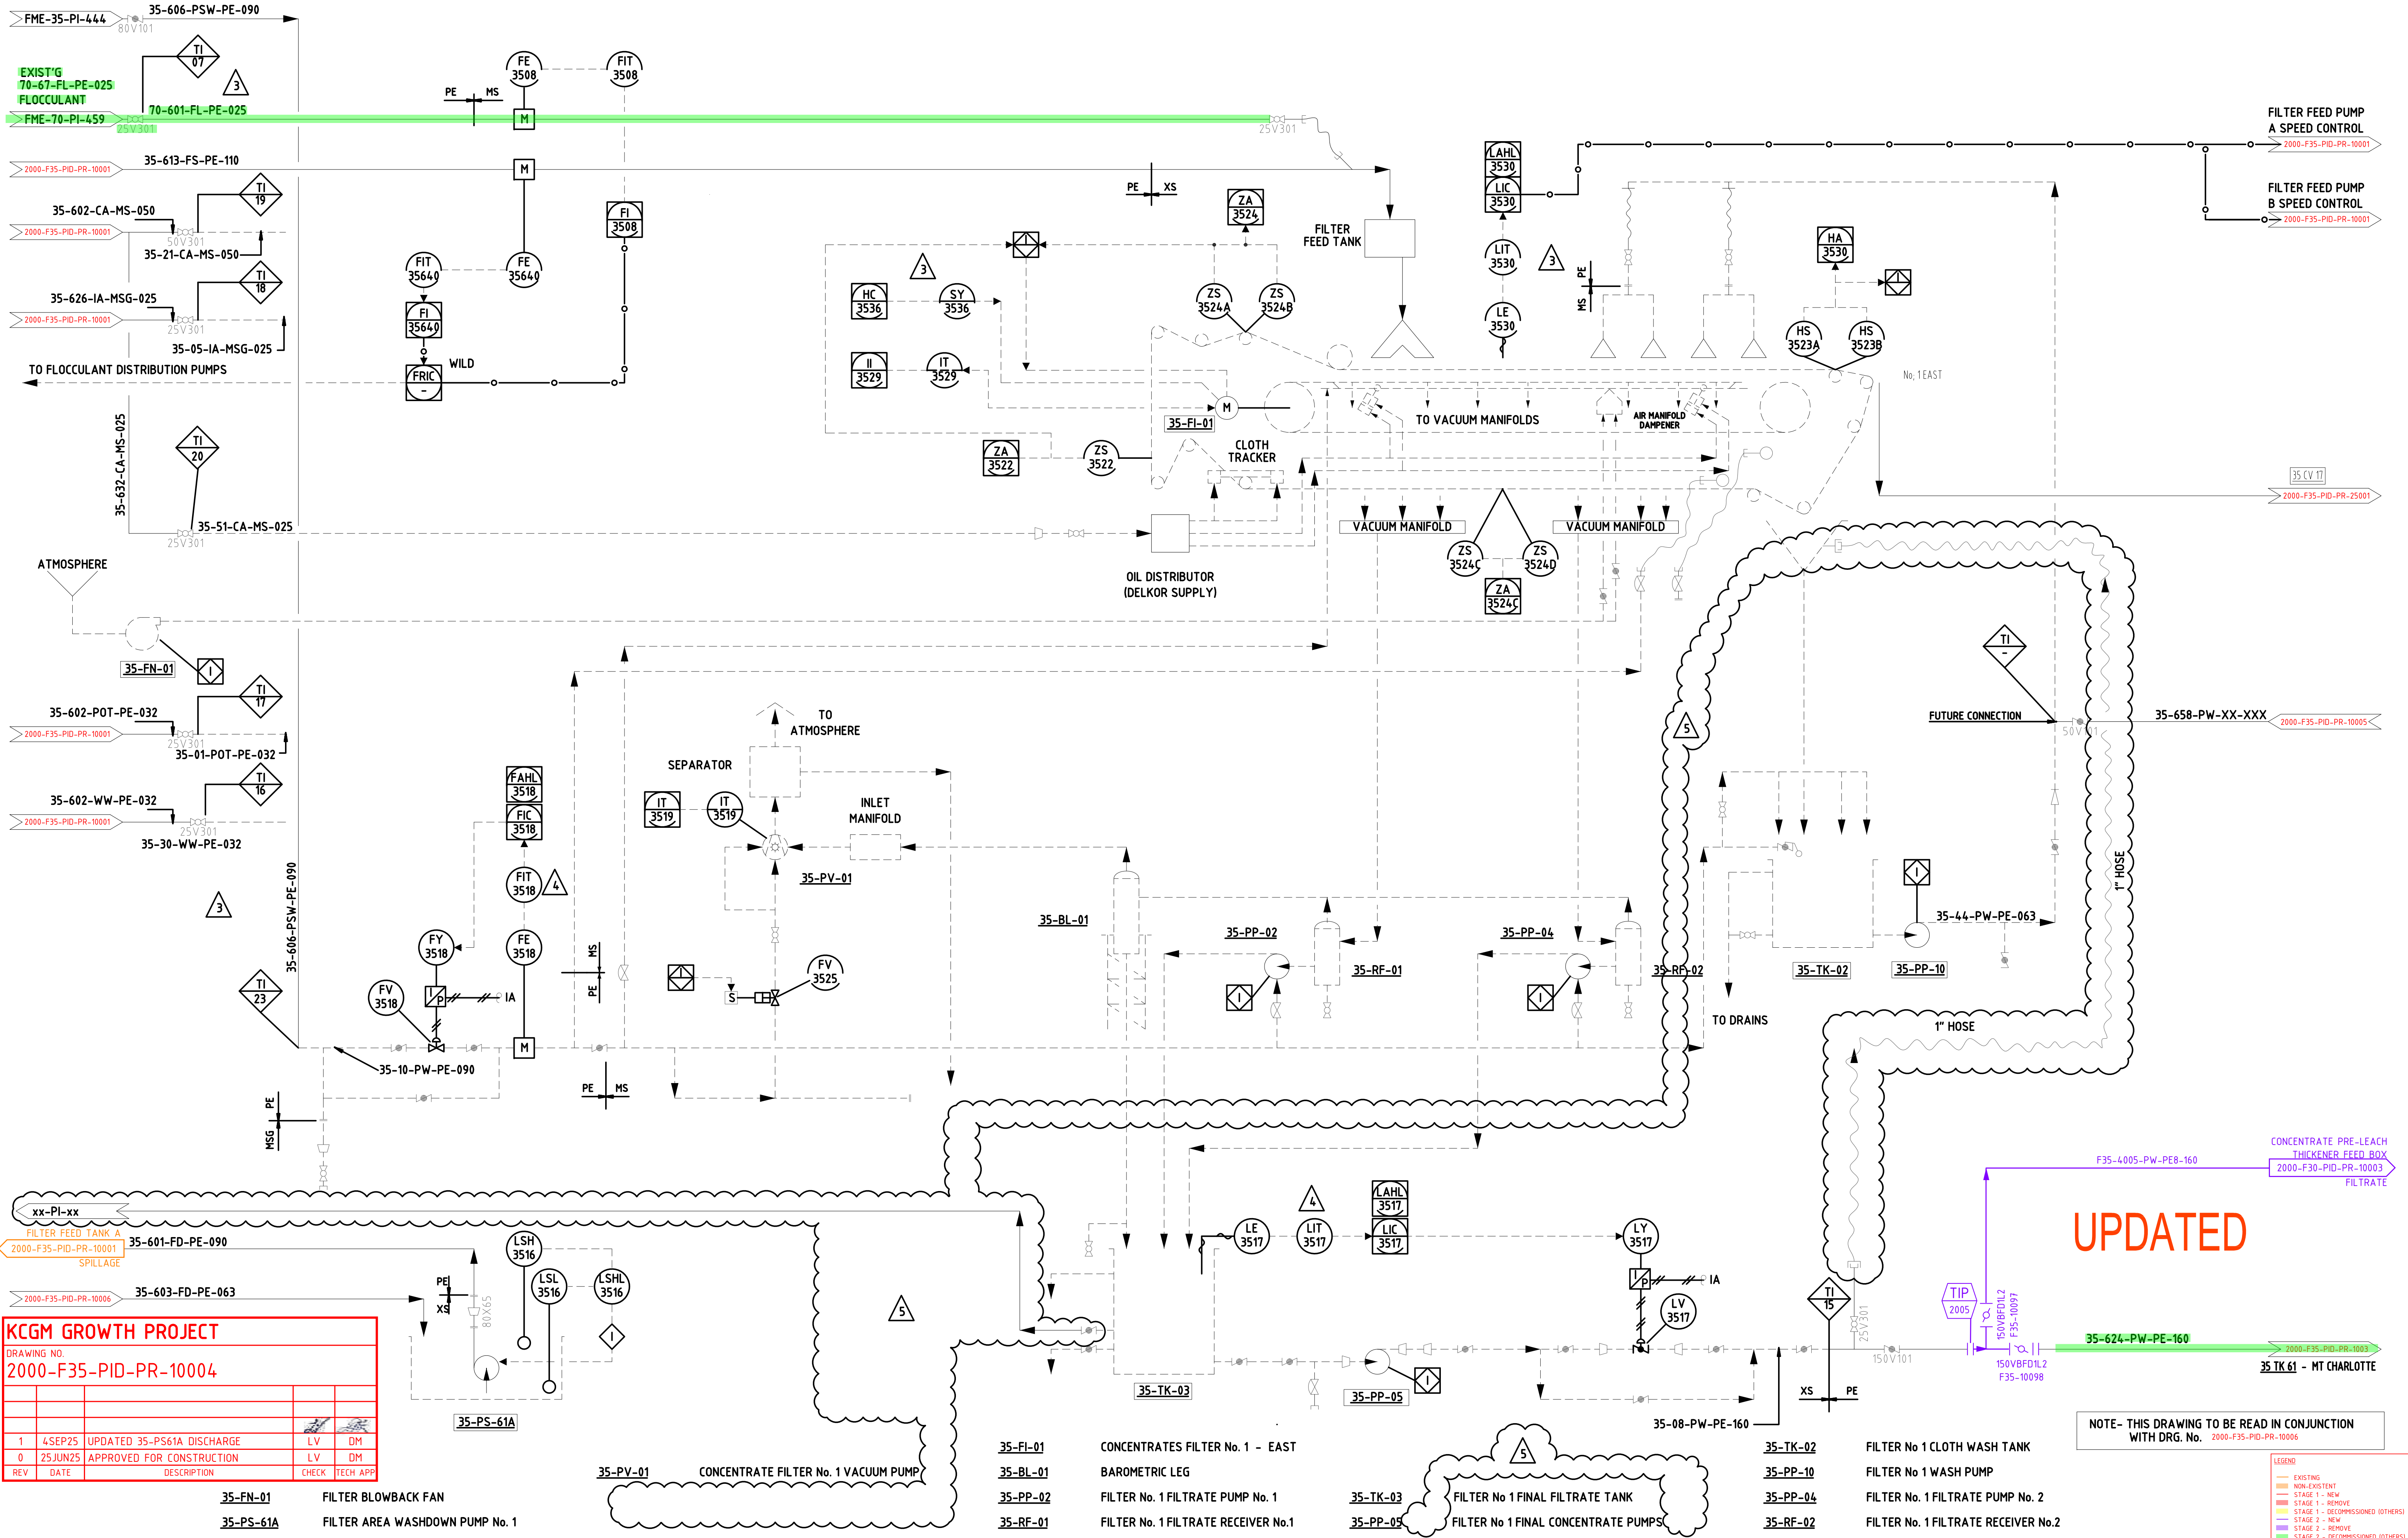

KCGM GROWTH PROJECT				
DRAWING NO. 2000-F35-PID-PR-10004				
REV	DATE	DESCRIPTION	CHECK	TECH APP
1	4SEP25	UPDATED 35-PS61A DISCHARGE	LV	DM
0	25JUN25	APPROVED FOR CONSTRUCTION	LV	DM

35-FN-01	FILTER BLOWBACK FAN
35-PS-61A	FILTER AREA WASHDOWN PUMP No. 1

DRAWING NO.	REFERENCE DRAWINGS
9241-00-PI-27	INSTRUMENT AIR DISTRIBUTION
9241-00-PI-26	COMPRESSOR AIR DISTRIBUTION
9241-00-PI-25	POTABLE WATER DISTRIBUTION
9241-00-PI-24	SCHEME WATER DISTRIBUTION
9241-00-PI-23	WASHDOWN WATER DISTRIBUTION

COPYRIGHT ©
This drawing remains the property of MINPROC ENGINEERS LIMITED and may not be copied in any way without prior written approval from this company.




MINPROC ENGINEERS LIMITED

A.C.N. 008 992 694
22, STIRLING HIGHWAY, NEDLANDS WA 6009
PHONE (09) 347 4777

No.	BY	DATE	REVISION	CHECKED	APPROV.
5	L.W.	30.04.2020	TK & PUMP REMD, REVISED - AS BUILT	T.R.	-
4	FW	30/11/94	REVISED AS NOTED SEE DWG SP-410	GT	-
3	PR	8/11/94	REVISED AS NOTED SEE DWG SP-410	GT	-
2	PR	31/10/94	APPROVED FOR CONSTRUCTION	GT	-
1	GT	25/10/94	ISSUED FOR MAT'L TAKE-OFF	GT	-
0	PR	12/09/94	APPROVED FOR TENDER	GT	-

No.	BY	DATE	REVISION	CHECKED	APPROV.
5	L.W.	30.04.2020	TK & PUMP REMD, REVISED - AS BUILT	T.R.	-
4	FW	30/11/94	REVISED AS NOTED SEE DWG SP-410	GT	-
3	PR	8/11/94	REVISED AS NOTED SEE DWG SP-410	GT	-
2	PR	31/10/94	APPROVED FOR CONSTRUCTION	GT	-
1	GT	25/10/94	ISSUED FOR MAT'L TAKE-OFF	GT	-
0	PR	12/09/94	APPROVED FOR TENDER	GT	-

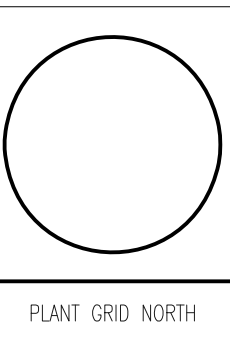

CUSTOMER	KALGOORLIE CONSOLIDATED GOLD MINES
TITLE	FIMISTON EXPANSION 1994/95 PIPING & INSTRUMENTATION DIAGRAM CONCENTRATE FILTER No1

SIZE	SCALE	REV.	DRAWING NO.
B1	N.T.S.	11121415	FME-35-PI-445

- LEGEND
- EXISTING
 - NON-EXISTENT
 - STAGE 1 - NEW
 - STAGE 1 - REMOVE
 - STAGE 1 - DECOMMISSIONED (OTHERS)
 - STAGE 2 - NEW
 - STAGE 2 - REMOVE
 - STAGE 2 - DECOMMISSIONED (OTHERS)