


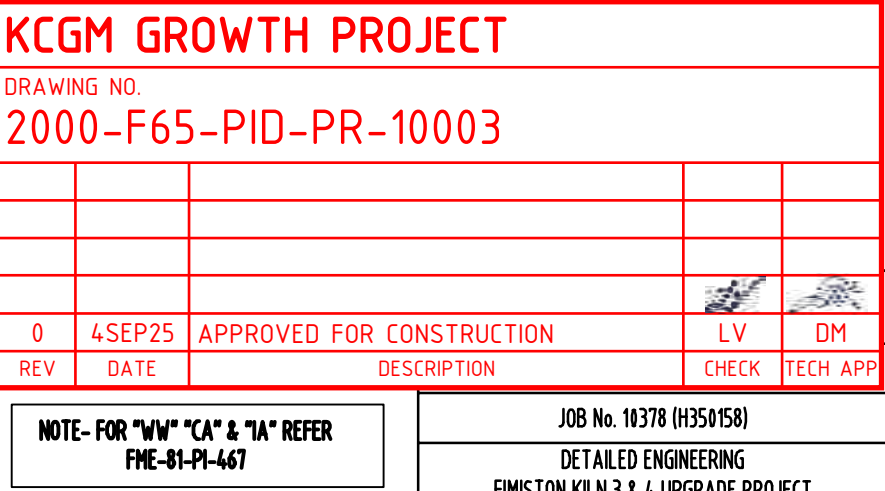

00-SP-415			MANUAL VALVE SCHEDULE									9	28.04.20	REVISED - 'AS BUILT'	L.W.	T.R.	-	3	19/06/98	NEW PIPE AND BUTTERFLY VALVE ADDED	SJD	JB	DRAWING LAST MODIFIED	APPROVALS	CLIENT	KALGOORLIE CONSOLIDATED GOLD MINES	DRAWING TITLE	DRAWING No	REV	SHEET SIZE A0												
00-SP-411			PIPPING LINE LIST INDEX ELUTION CIR/C/GOLD ROOM									8	8.12.15	APPROVED FOR CONSTRUCTION	DC	DVB	PF	2	14.11.97	KV65506 WAS SHOWN AS BUTTERFLY VALVE	BR										DRAWN	RAC	23/06/97	DRAWING TITLE	DRAWING No	REV	SHEET SIZE A0					
00-P-401			PIPPING KEY PLAN									7	11/7/07	LINE FROM 65-BN-61 & 62 MOD. - 1/1 FLOW FROM 65-CH-65 & 76 MOD.	D.K.L.	C.T.	1	15.9.97	SI-65556, IT-65557, XS-65558, SI-65517 & IT-65518 ADDED	LR		DESIGNED									C.H.	23.06.97	DRAWING TITLE					DRAWING No	REV	SHEET SIZE A0		
00-SP-400			INSTRUMENT STANDARDS									6	25.08.06	'AS BUILT'	L.W.	BR	0	28.08.97	ISSUED FOR CONSTRUCTION FIMSTON CONSOLIDATION PROJ. 1997	LR	JFW	CJM									CHECKED	JFW									19.08.97	DRAWING TITLE
00-SP-406			STANDARD ABBREV. & VALVE SYMBOLS			65/PIV0459	PIPPING AND INSTRUMENTATION DIAGRAM			CARBON REGENERATION SHEET 2 OF 2			5	18.07.06	LINEs ADDED TO SCRUBBER	L.W.	BR	8	18.8.97	TAG NUMBERS ADDED	LR		APPROVED	CJM	19.08.97	DRAWING TITLE	DRAWING No	REV	SHEET SIZE A0													
00-SP-403			STANDARD EQUIPMENT SYMBOLS			00-SP-410	MISCELLANEOUS EQUIP LIST						4	29.07.95	2 VALVES AS NOTED. LINE 65-609-CW-XS-050 REMOVED	L.W.	SW	MD	4	29.07.97	ISSUED FOR TENDER FIMSTON CONSOLIDATION PROJECT 1997	LR	JFW	CLIENT						NTS	DRAWING TITLE	DRAWING No		REV	SHEET SIZE A0							
DRAWING No			REFERENCE DRAWINGS			DRAWING No			REFERENCE DRAWINGS			REV	DATE	REVISION DESCRIPTION			BY	CHK	APP	REV	DATE	REVISION DESCRIPTION			BY					CHK			APP			SCALE	NTS	DRAWING TITLE	DRAWING No	REV	SHEET SIZE A0	
																																	DRAWING TITLE			DRAWING No	REV					SHEET SIZE A0
																															DRAWING TITLE	DRAWING No		REV	SHEET SIZE A0							