


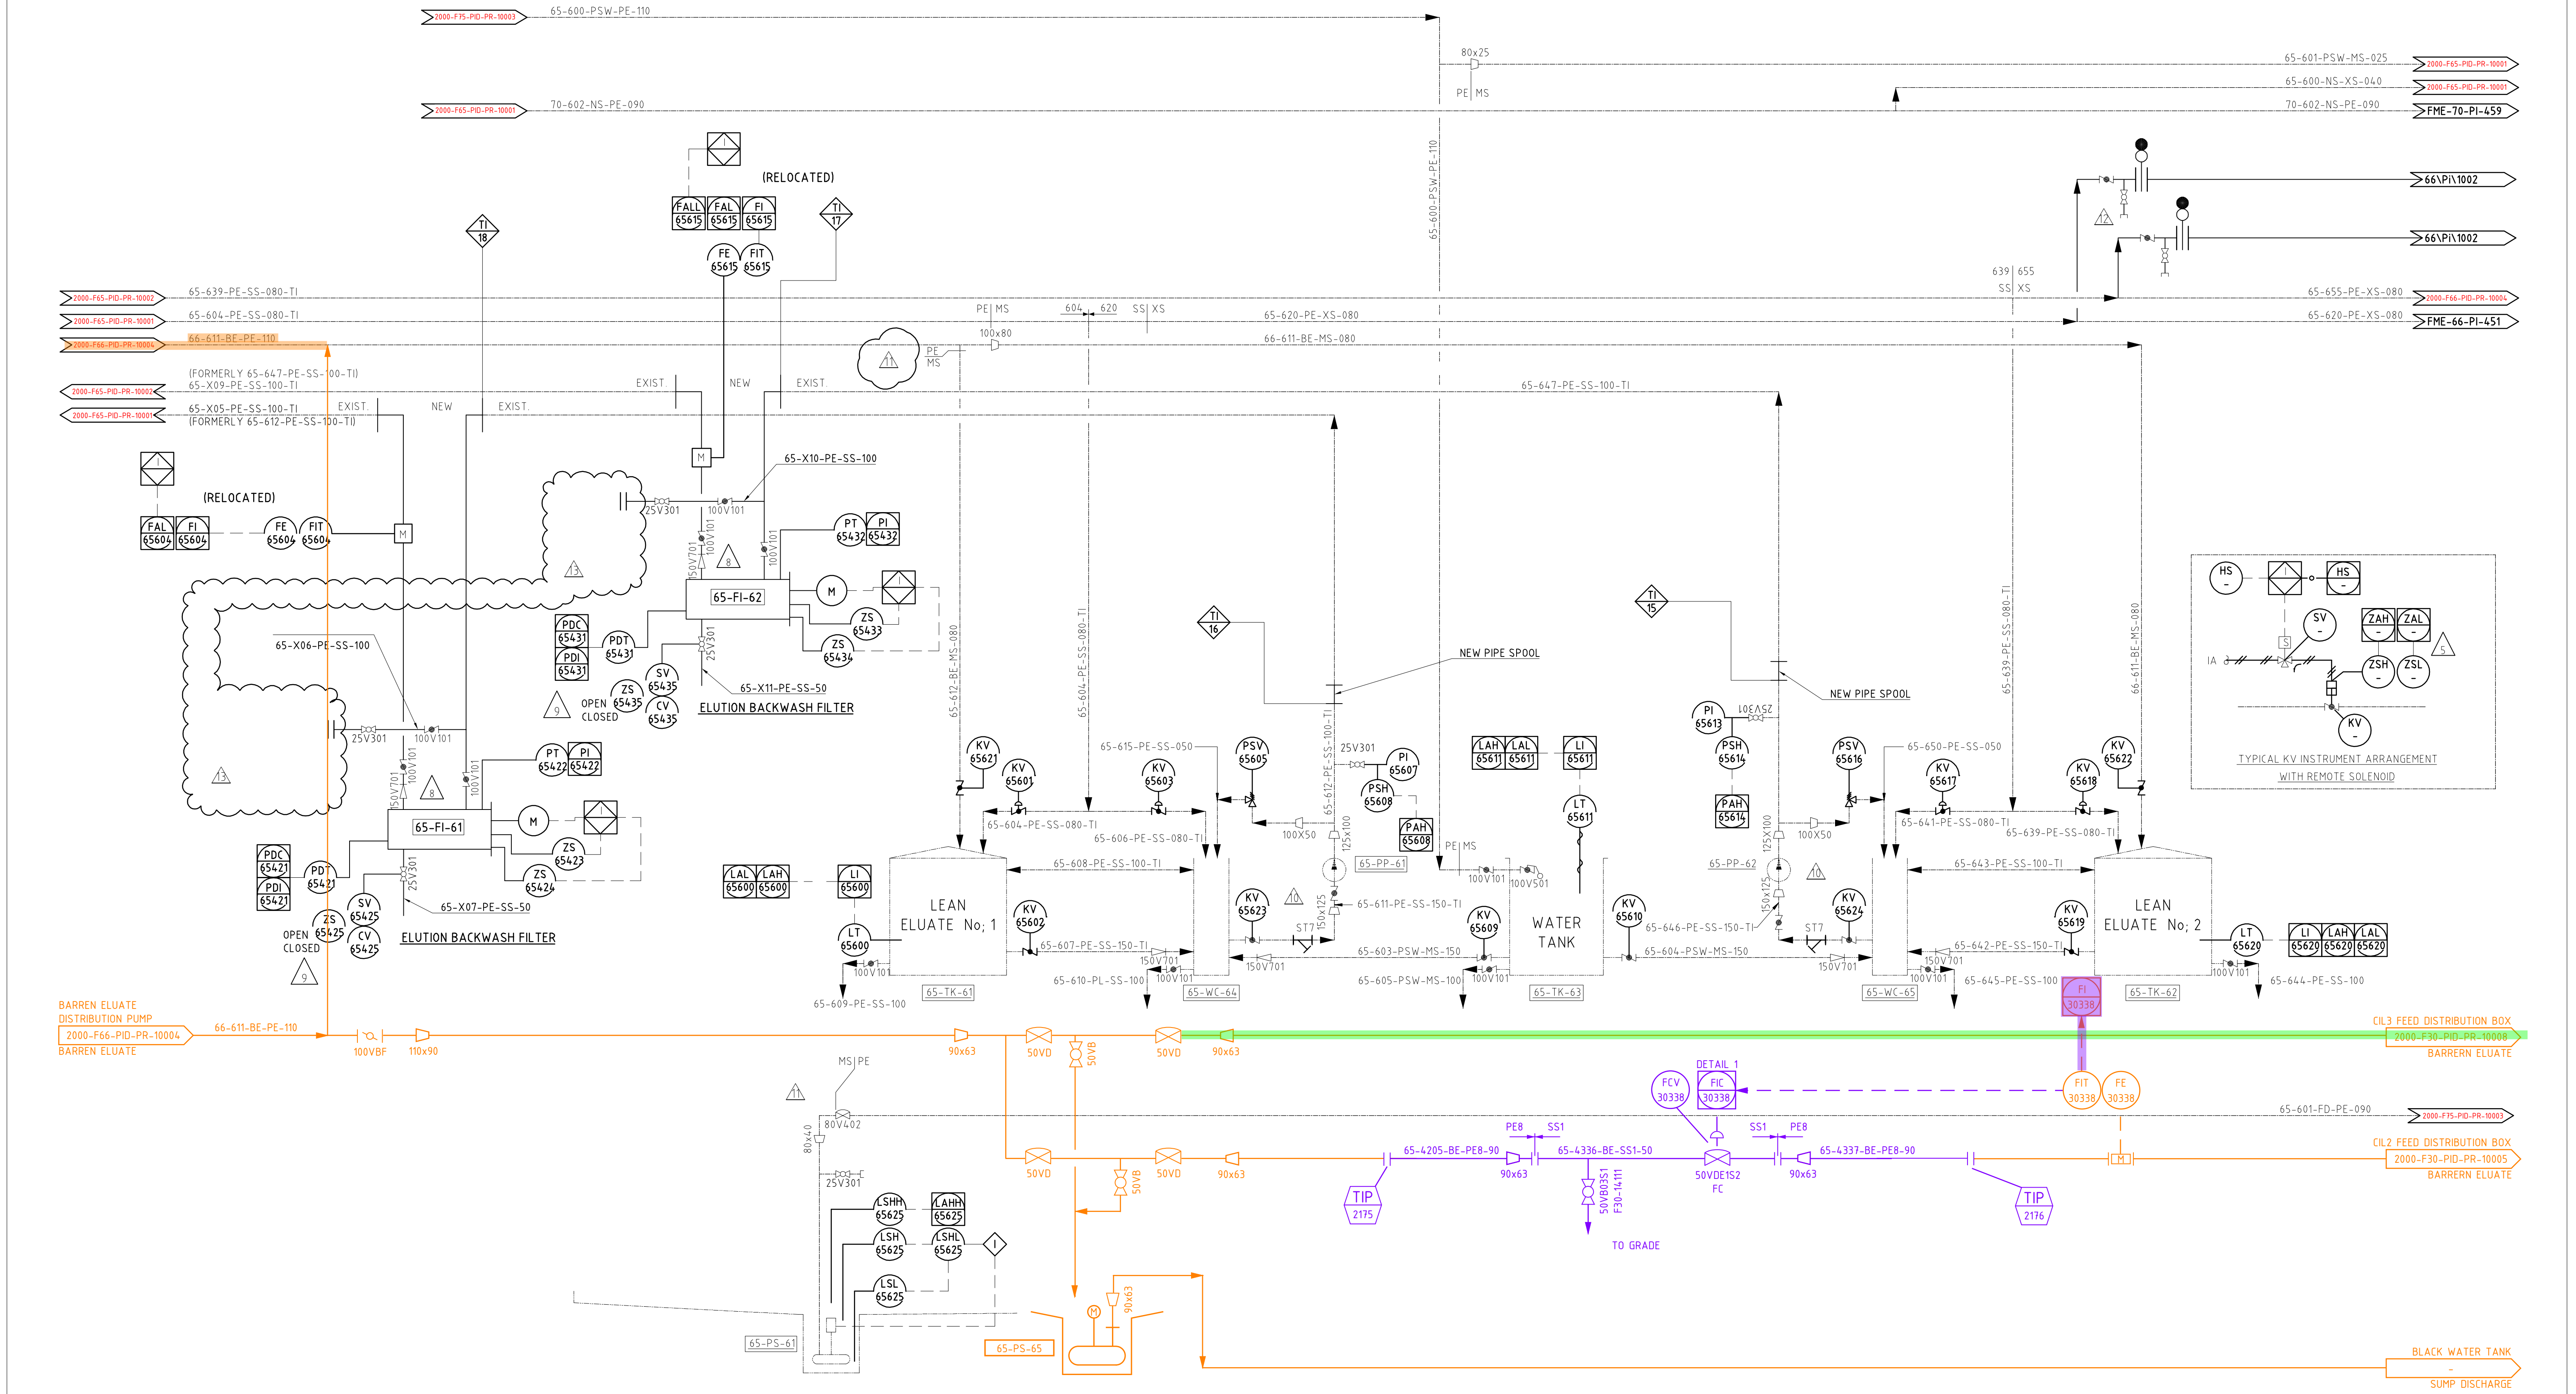

NOTES:
1. FOR "WW" "CA" & "IA" REFER FME-81-PI-0467

- | | | | |
|----------|---|----------|--|
| 65-TK-61 | LEAN ELUATE TANK No 1 | 65-PP-62 | ELUTION CIRCUIT No 2 WATER PUMP |
| 65-PP-61 | ELUTION CIRCUIT No 1 WATER PUMP | 65-WC-65 | ELUTION CIRCUIT No 2 RECYCLE STANDPIPE |
| 65-WC-64 | ELUTION CIRCUIT No 1 RECYCLE STAND PIPE | 65-TK-62 | LEAN ELUATE TANK No 2 |
| 65-PS-61 | ELUTION AREA WASHDOWN PUMP | | |
| 65-PS-65 | CARBON TRANSFER AREA SUMP PUMP | | |
| 65-FI-61 | ELUTION BACKWASH FILTER No 1 | | |
| 65-FI-62 | ELUTION BACKWASH FILTER No 2 | | |
| 65-TK-63 | ELUTION WATER TANK | | |

LEGEND

- EXISTING
- NON-EXISTENT
- STAGE 1 - NEW
- STAGE 1 - REMOVE
- STAGE 1 - DECOMMISSIONED (OTHERS)
- STAGE 2 - NEW
- STAGE 2 - REMOVE
- STAGE 2 - DECOMMISSIONED (OTHERS)

KCGM GROWTH PROJECT

DRAWING No. 2000-F65-PID-PR-10005

REV	DATE	DESCRIPTION	LV	DM
0	4SEP25	APPROVED FOR CONSTRUCTION		

FME-00-SP-419 MISCELLANEOUS EQUIP. LIST CONTRACT #F037		COPYRIGHT © This drawing remains the property of MINPROC ENGINEERS LIMITED and may not be copied in any way without prior written approval from this company.	MINPROC ENGINEERS LIMITED A.C.N. 008 992 694 22, STIRLING HIGHWAY, NEDLANDS WA 6009 PHONE (09) 347 4777	13	L.W.	28.04.2020	SAMPLE STATION'S REMOVED - "AS BUILT"	T.R.	6	gt	9/695	LN3 65-603/604-NS REMOVED			PROJECT APPR. BY DATE D.MARSHALL 9/3/95 DESIGN APPR. D.TAYLOR 3/5/95 DESIGNED D.TURNER 20/2/95 CHECKED G.TORKINGTON 28/2/95		CLIENT KALGOORLIE CONSOLIDATED GOLD MINES	TITLE FIMISTON EXPANSION 1994/95 PIPING & INSTRUMENTATION DIAGRAM LEAN ELUATE CIRCUIT	SIZE B1	SCALE N.T.S.																																																																																																																																																																																																																																																																																																																																																																																																																																																																																																																																																																																																																																																																																																																																																																																																																																																																																																																																																																																																																																																																																																																																																																																																																																																											
FME-00-SP-415 MANUAL VALVE SCHEDULE	12			JMD	15/06/16	ELUATE BYPASS TANK ADDED	-	5	PR	8/5/95	REVISED AS NOTED	GT	AH	REV. 01 11 21 23 24 25 26 27 28 29 30 31																																																																																																																																																																																																																																																																																																																																																																																																																																																																																																																																																																																																																																																																																																																																																																																																																																																																																																																																																																																																																																																																																																																																																																																																																																																																	
FME-00-SP-411 PIPING LINE LIST ELUTION CIRC./GOLD ROOM	11			DL	11/7/07	LINE No 64-68-BE-MS-AN 1 & 45-40-FD-PE-MS REMOVED	C.T.	4	PR	19/4/95	REVISED AS NOTED	GT	EJ	27/13																																																																																																																																																																																																																																																																																																																																																																																																																																																																																																																																																																																																																																																																																																																																																																																																																																																																																																																																																																																																																																																																																																																																																																																																																																																																	
FME-00-P-401 PIPING KEYPLAN	10			LW	29/07/05	VALVES ADDED - AS NOTED	SW	MO	3	PR	31/3/95	REVISED AS NOTED	GT	EJ																																																																																																																																																																																																																																																																																																																																																																																																																																																																																																																																																																																																																																																																																																																																																																																																																																																																																																																																																																																																																																																																																																																																																																																																																																																																	
FME-00-SP-408 INSTRUMENT STANDARDS	9			DA	19/2/00	L/ S'S ADDED TO FLUSHING VALVES		2	PR	10/2/95	APPROVED FOR CONSTRUCTION	GT	EJ																																																																																																																																																																																																																																																																																																																																																																																																																																																																																																																																																																																																																																																																																																																																																																																																																																																																																																																																																																																																																																																																																																																																																																																																																																																																		
FME-00-SP-404 STANDARD ABBREV. & VALVE SYMBOLS				8	DL	3/2/2000	CHK VALVES ADDED - "AS BUILT"	DL	1	PR	27/1/95	RE-ISSUED FOR TENDER																																																																																																																																																																																																																																																																																																																																																																																																																																																																																																																																																																																																																																																																																																																																																																																																																																																																																																																																																																																																																																																																																																																																																																																																																																																																			
FME-00-SP-403 STANDARD EQUIPMENT SYMBOLS		7	DL	29/10/99	FILTERS 65-FI-01 & 02 ADDED	DL	MD	0	PGN	21/12/94	APPR. FOR TENDER - F037																																																																																																																																																																																																																																																																																																																																																																																																																																																																																																																																																																																																																																																																																																																																																																																																																																																																																																																																																																																																																																																																																																																																																																																																																																																																				

REV. No. 01/11/21/14/18/16/17/18/2115/211