
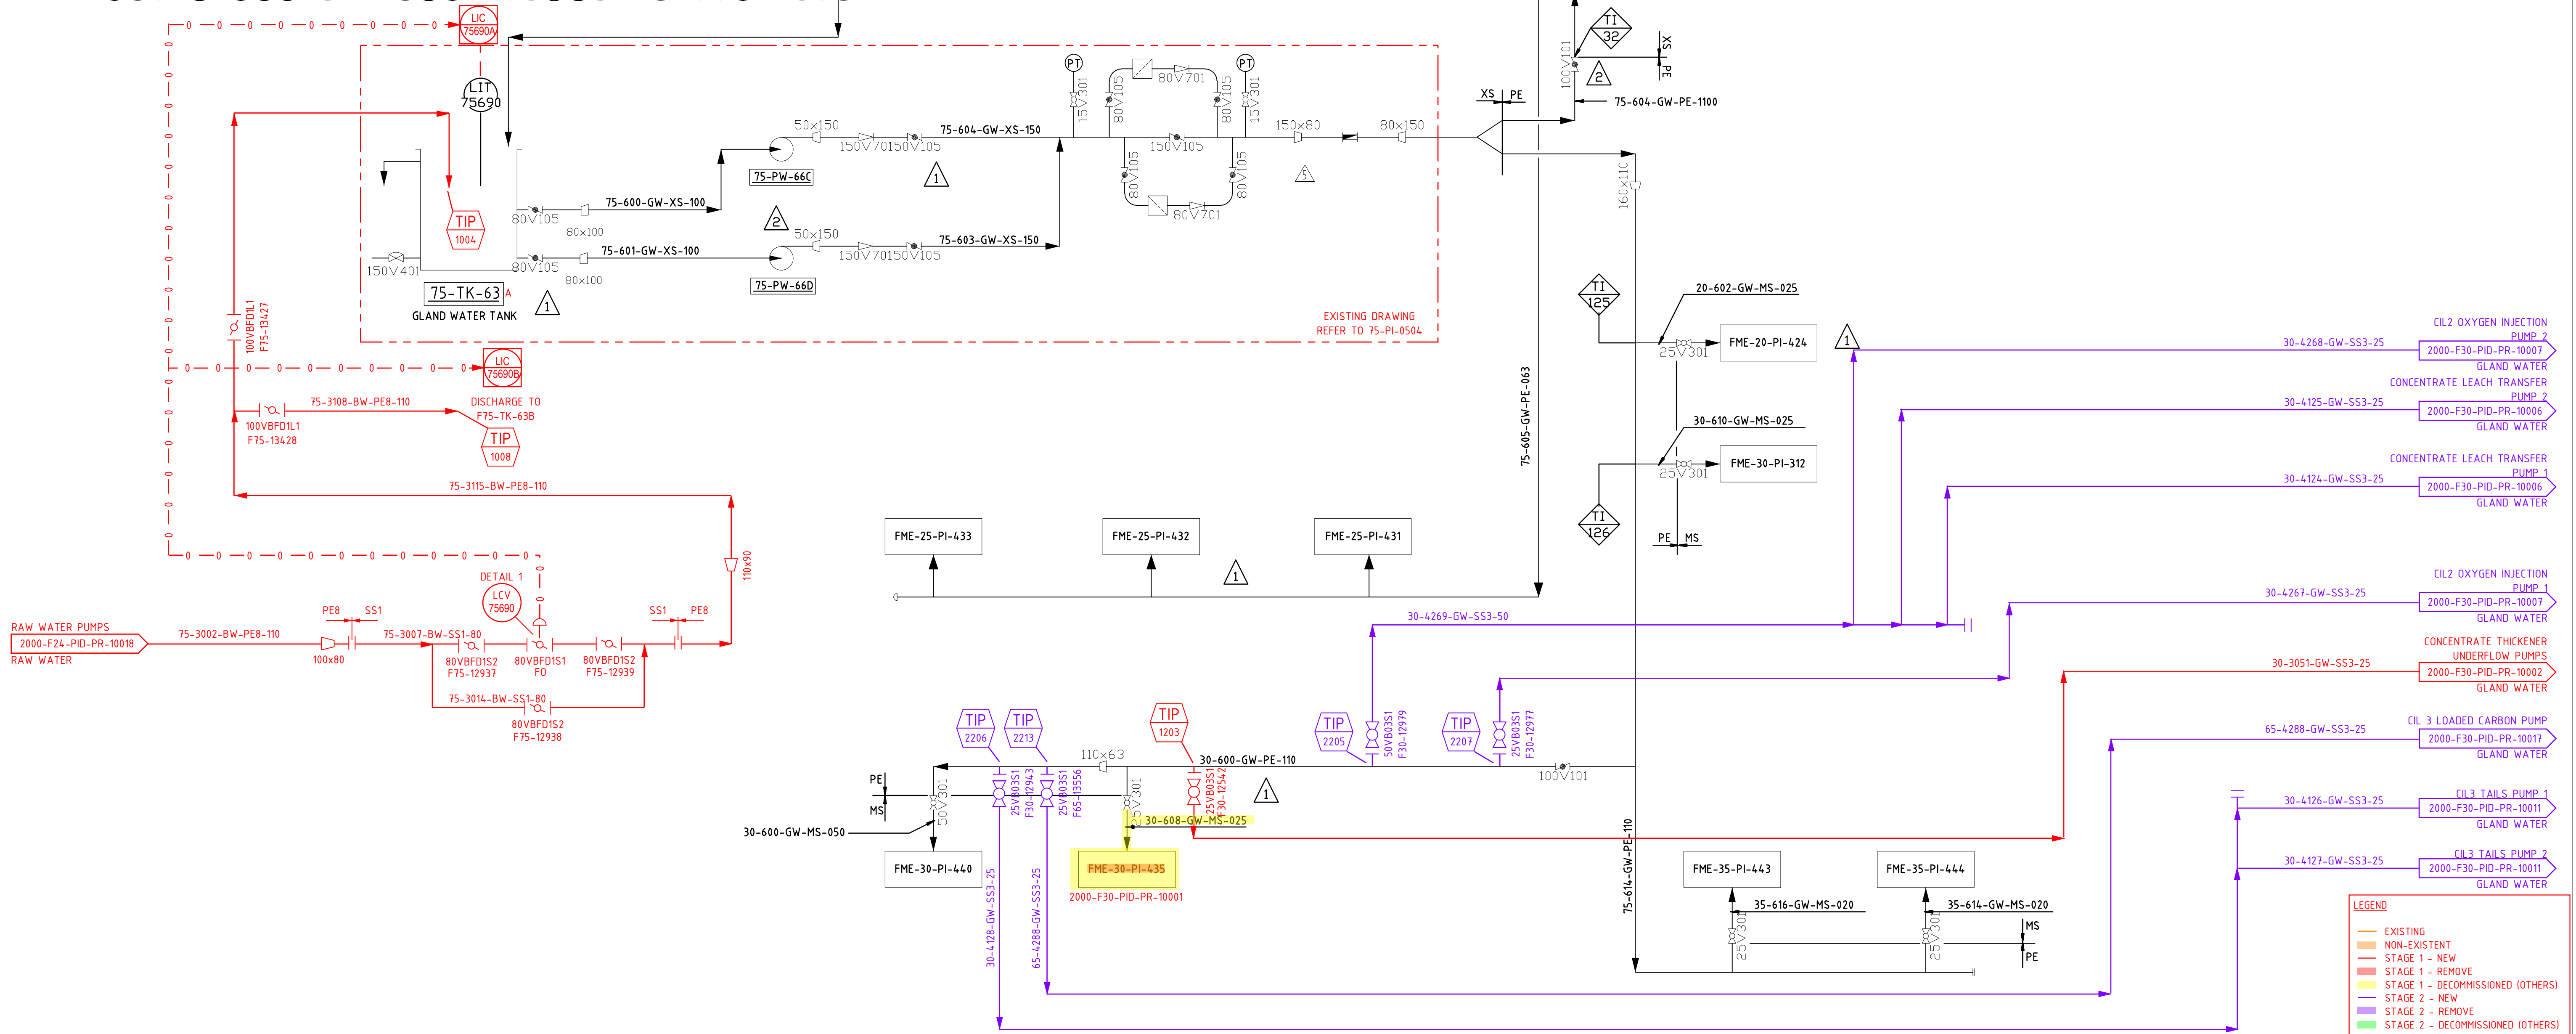


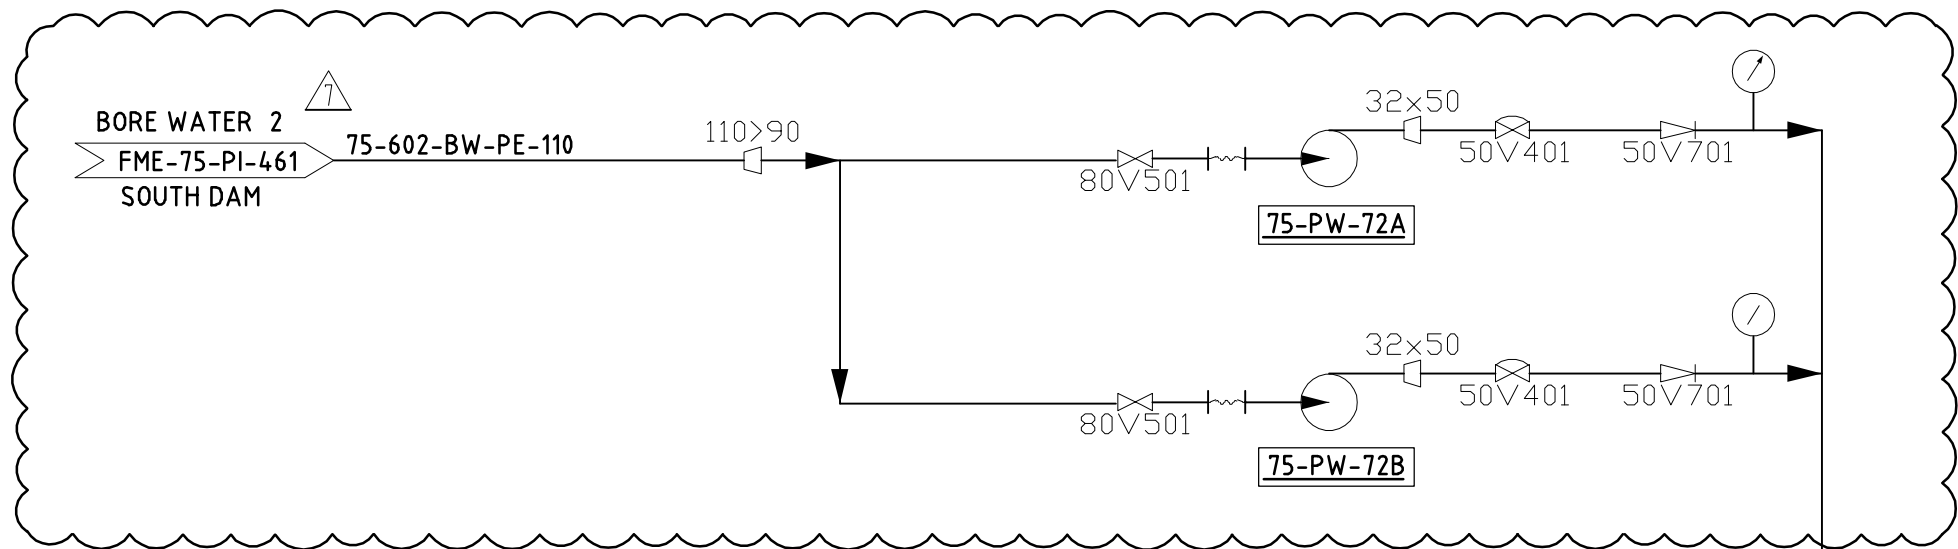

LEGEND			
—	EXISTING		
—	NON-EXISTENT		
—	STAGE 1 - NEW		
—	STAGE 1 - REMOVE		
—	STAGE 1 - DECOMMISSIONED (OTHERS)		
—	STAGE 2 - NEW		
—	STAGE 2 - REMOVE		
—	STAGE 2 - DECOMMISSIONED (OTHERS)		

NOTES:

- THIS DRAWING TO BE READ IN CONJUNCTION WITH P&ID 75-PI-0504
- PUMPS REQUIRING GLAND WATER THAT ARE WITHIN BROWNFIELDS SCOPE ARE TO TIE IN TO THE EXISTING GLAND WATER CIRCUIT. REFER TO 2000-F24-PID-PR-10034 AND 2000-F24-PID-PR-10035 FOR BROWNFIELDS GLAND WATER DETAIL

NOTE. GLAND WATER POLYETHYLENE PIPES TO BE PE 80 TYPE B PN10

KCGM GROWTH PROJECT

DRAWING NO. 2000-F75-PID-PR-10007

REV	DATE	DESCRIPTION	CHECK	TECH APP
1				
0	25JUN25	NEW LINE TO F75-TK-63B	LV	DM
		APPROVED FOR CONSTRUCTION	LV	DM

SIZE	SCALE
B1	N.T.S.
REV. No.	11121314151617
DRAWING No.	75\PI\0462

DRAWING No.	REFERENCE DRAWINGS
75\PI\1083	GLAND SEAL WATER PUMP DISCHARGE MOD'S
FME-00-SP-403	STANDARD EQUIPMENT SYMBOLS
FME-00-SP-404	ABBREVIATIONS & VALVE SYMBOLS
FME-00-SP-408	INSTRUMENT STANDARDS

COPYRIGHT ©

This drawing remains the property of MINPROC ENGINEERS LIMITED and may not be copied in any way without prior written approval from this company.

MINPROC ENGINEERS LIMITED

A.C.N. 008 992 694

22, STIRLING HIGHWAY, NEDLANDS WA 6009

PHONE (09) 347 4777

No.	BY	DATE	REVISION	CHECKED	APPROV.
6	DL	31/1/2008	REF TO Dwg No 19\PI\409 REMOVED		
5	DL	5/2/2002	MOD'S AS PER 75\PI\1083 ADDED		
4	SB	21/4/95	APPROVED FOR CONSTRUCTION F035		
3	SB	3/4/95	APPROVED FOR TENDER BALL MILLS 1 & 2		
2	SB	17/3/95	APPROVED FOR TENDER F035		
1	PR	12/12/94	REVISED AS NOTED SEE DRG#SP-410		
0	PR	5/12/94	APPROVED FOR CONSTRUCTION		
7	L.W.	11.05.2020	TANK REMOVED. PUMP ADDED - AS BUILT	T.R.	

PROJECT APPR.	BY	DATE
	D.MARSHALL	5/12/94
DESIGN APPR.	D.TAYLOR	5/12/94
DESIGNED	D.TAYLOR	5/12/94
CHECKED	G.TORKINGTON	5/12/94
DRAWN	P.ROWE	5/12/94

CLIENT

KALGOORLIE CONSOLIDATED GOLD MINES

TITLE

FIMISTON EXPANSION 1994/95
PIPING & INSTRUMENT DIAGRAM
GLAND WATER SYSTEM

PLANT GRID NORTH