


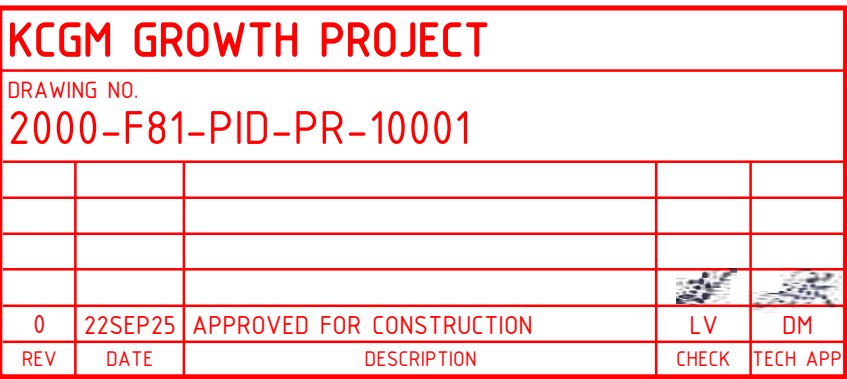

COPYRIGHT ©

This drawing remains the property of MINPROC ENGINEERS LIMITED and may not be copied in any way without prior written approval from this company.

A.C.N. 008 992 694  
22, STIRLING HIGHWAY, NEDLANDS WA 6009  
PHONE (09) 347 4777

|     |      |            |                              |         |         |
|-----|------|------------|------------------------------|---------|---------|
|     |      |            |                              |         |         |
|     |      |            |                              |         |         |
| 2   | L.W. | 28.04.2020 | EQUIP NUMBERS ADDED-AS BUILT | T.R.    | -       |
| 1   | DL   | 14/12/07   | 2nd LPG CYLINDER REMOVED     |         |         |
| 0   | SB   | 05/12/94   | ISSUED FOR CONSTRUCTION      |         |         |
| No. | BY   | DATE       | REVISION                     | CHECKED | APPROV. |



PLANT GRID NORTH

|             |        |   |  |  |  |  |  |  |  |  |  |  |  |
|-------------|--------|---|--|--|--|--|--|--|--|--|--|--|--|
| SIZE        | SCALE  |   |  |  |  |  |  |  |  |  |  |  |  |
| B1          | N.T.S. |   |  |  |  |  |  |  |  |  |  |  |  |
| REV.        | 1      | 2 |  |  |  |  |  |  |  |  |  |  |  |
| No.         |        |   |  |  |  |  |  |  |  |  |  |  |  |
| DRAWING No. |        |   |  |  |  |  |  |  |  |  |  |  |  |
| 81\PI\0465  |        |   |  |  |  |  |  |  |  |  |  |  |  |