


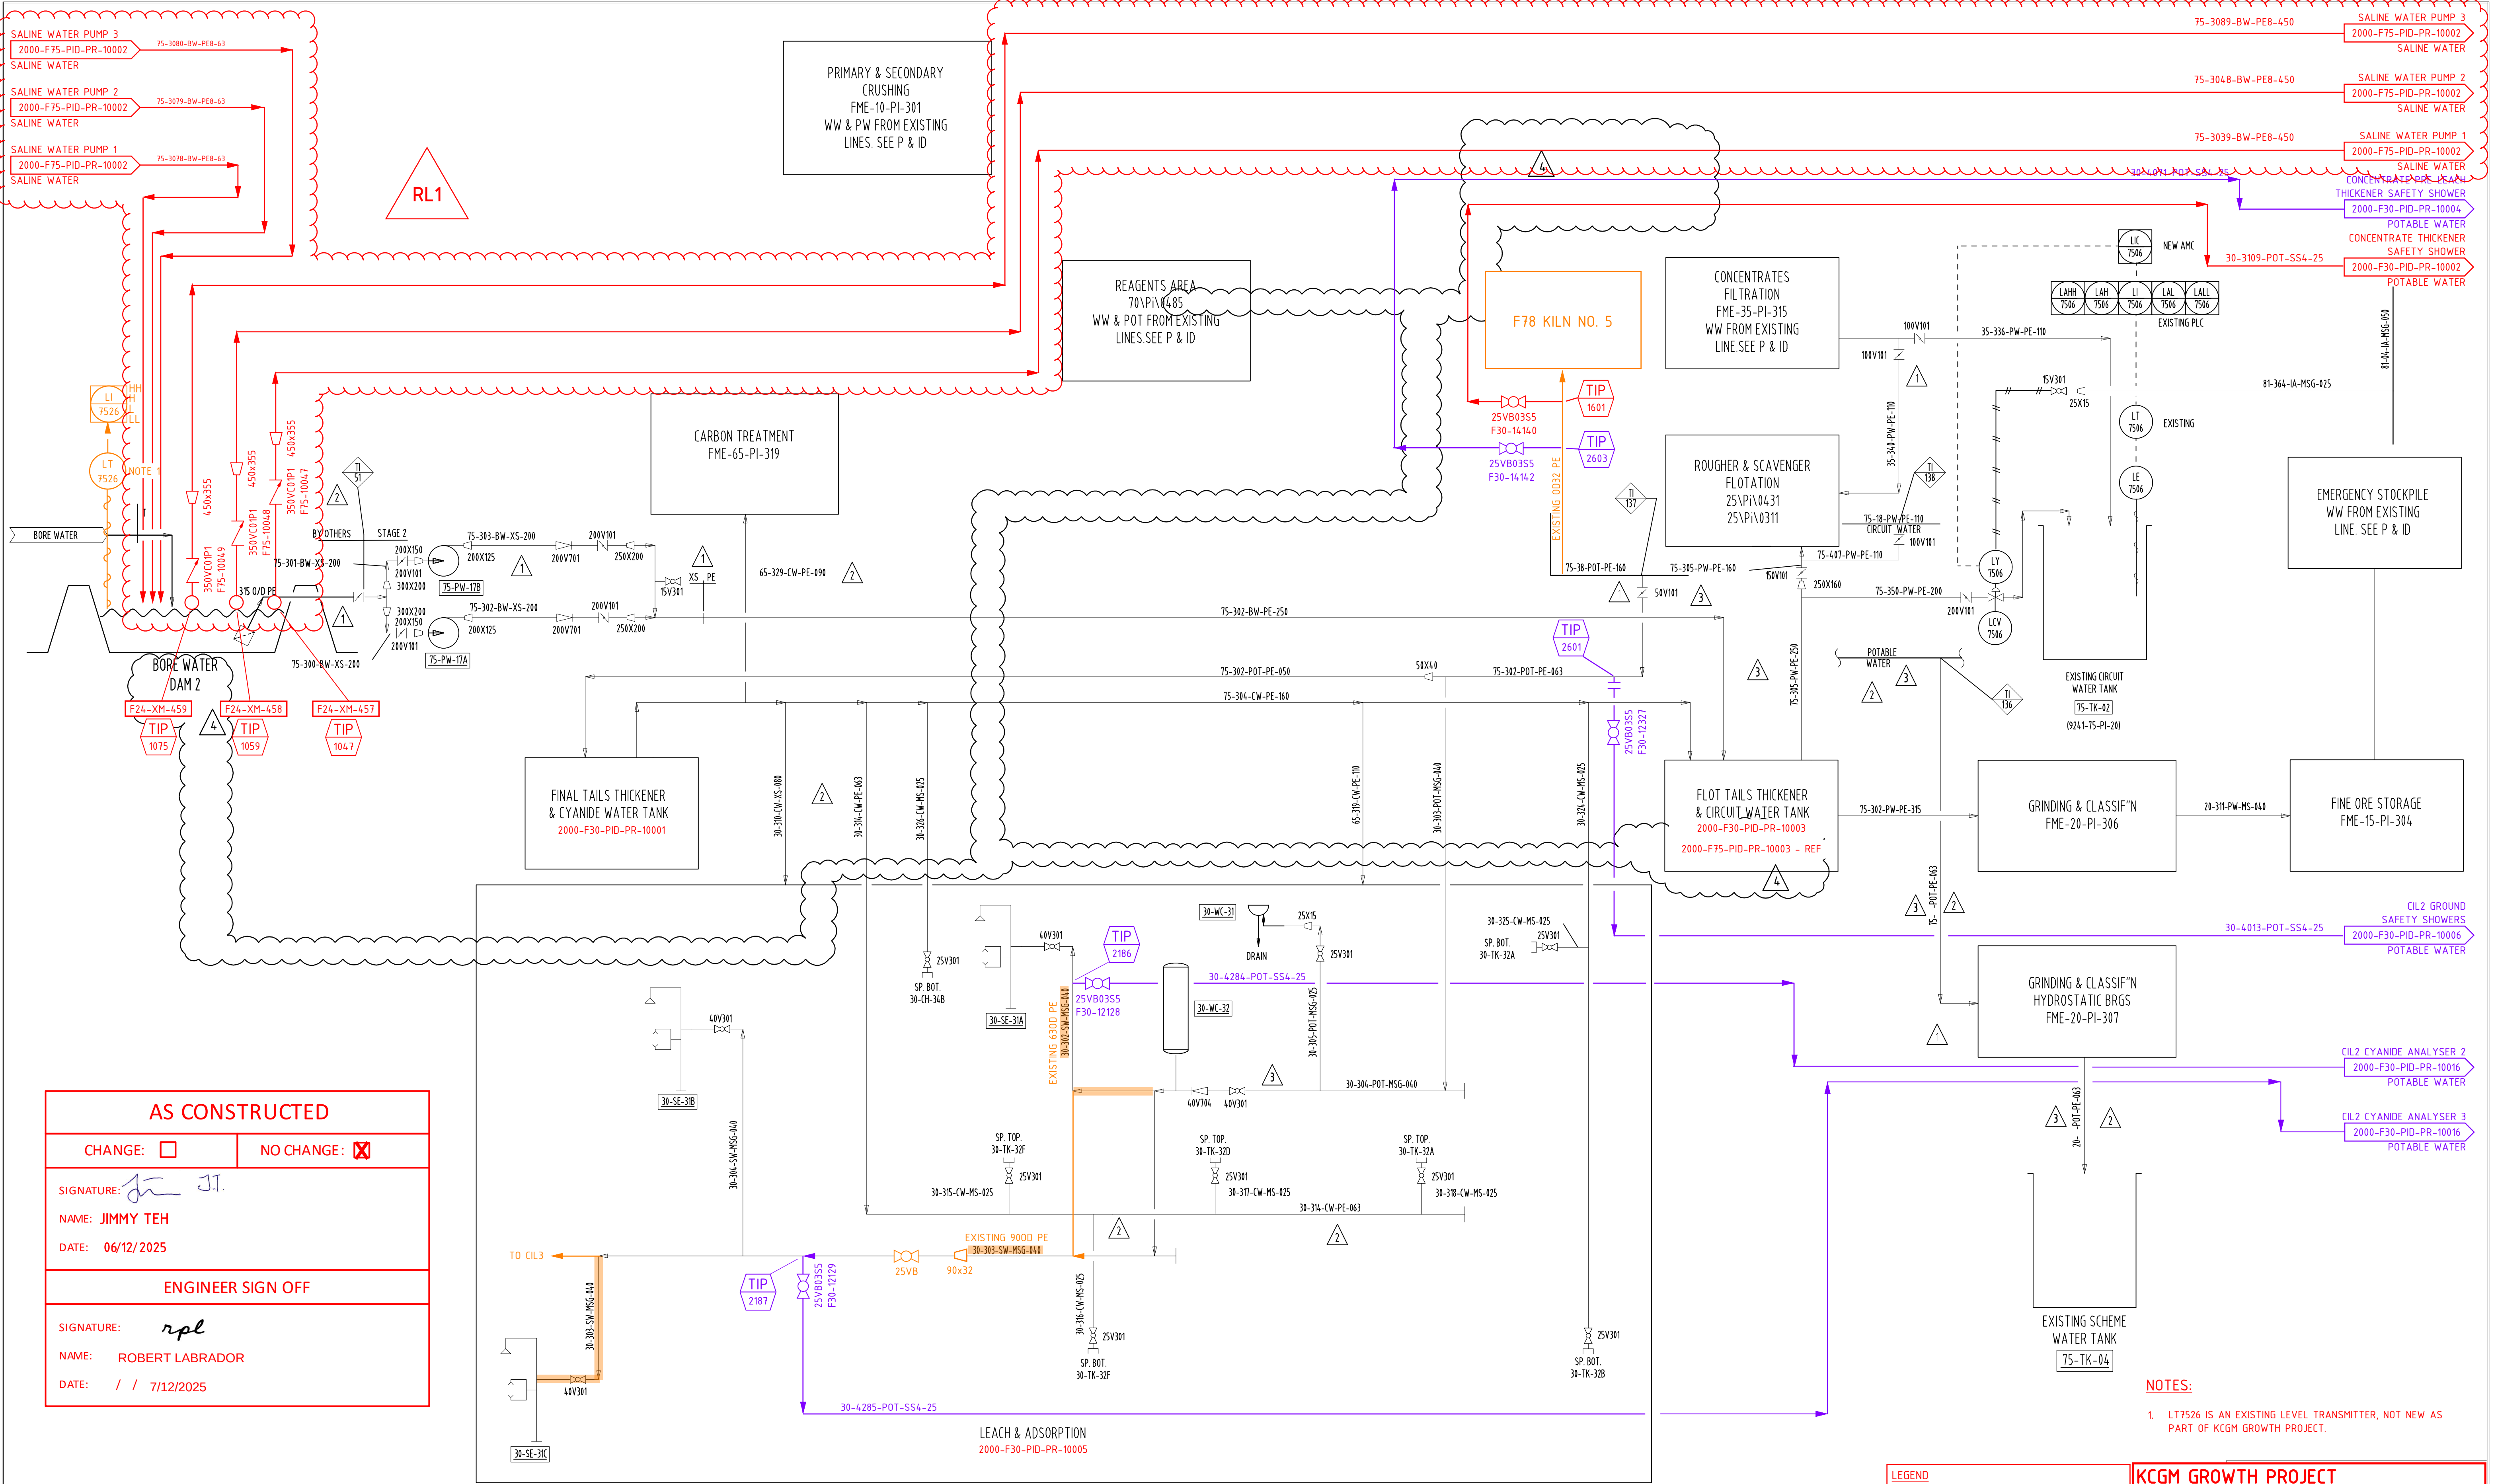

AS CONSTRUCTED

CHANGE: ☐

NO CHANGE: ☒

SIGNATURE:

NAME: JIMMY TEH

DATE: 06/12/2025

ENGINEER SIGN OFF

SIGNATURE:

NAME: ROBERT LABRADOR

DATE: / / 7/12/2025

NOTES:

1. LT7526 IS AN EXISTING LEVEL TRANSMITTER, NOT NEW AS PART OF KCGM GROWTH PROJECT.

LEGEND					KCGM GROWTH PROJECT				
EXISTING					DRAWING NO. 2000-F75-PID-PR-10001				
NON-EXISTENT									
STAGE 1 - NEW									
STAGE 1 - REMOVE									
STAGE 1 - DECOMMISSIONED (OTHERS)									
STAGE 2 - NEW									
STAGE 2 - REMOVE									
STAGE 2 - DECOMMISSIONED (OTHERS)									

		COPYRIGHT ©		MINPROC ENGINEERS PTY. LTD.																																																																																																																																																																																																																																																																																																																																																																																																																																																																																																																																																																																																																																																																																																																																																																																																																																																																																																																																																																																																																																																																																																																																																																																																																																																																																																																																																																																																																																																																																																																																																																																																																																													
--	--	-------------	--	-----------------------------	--	--	