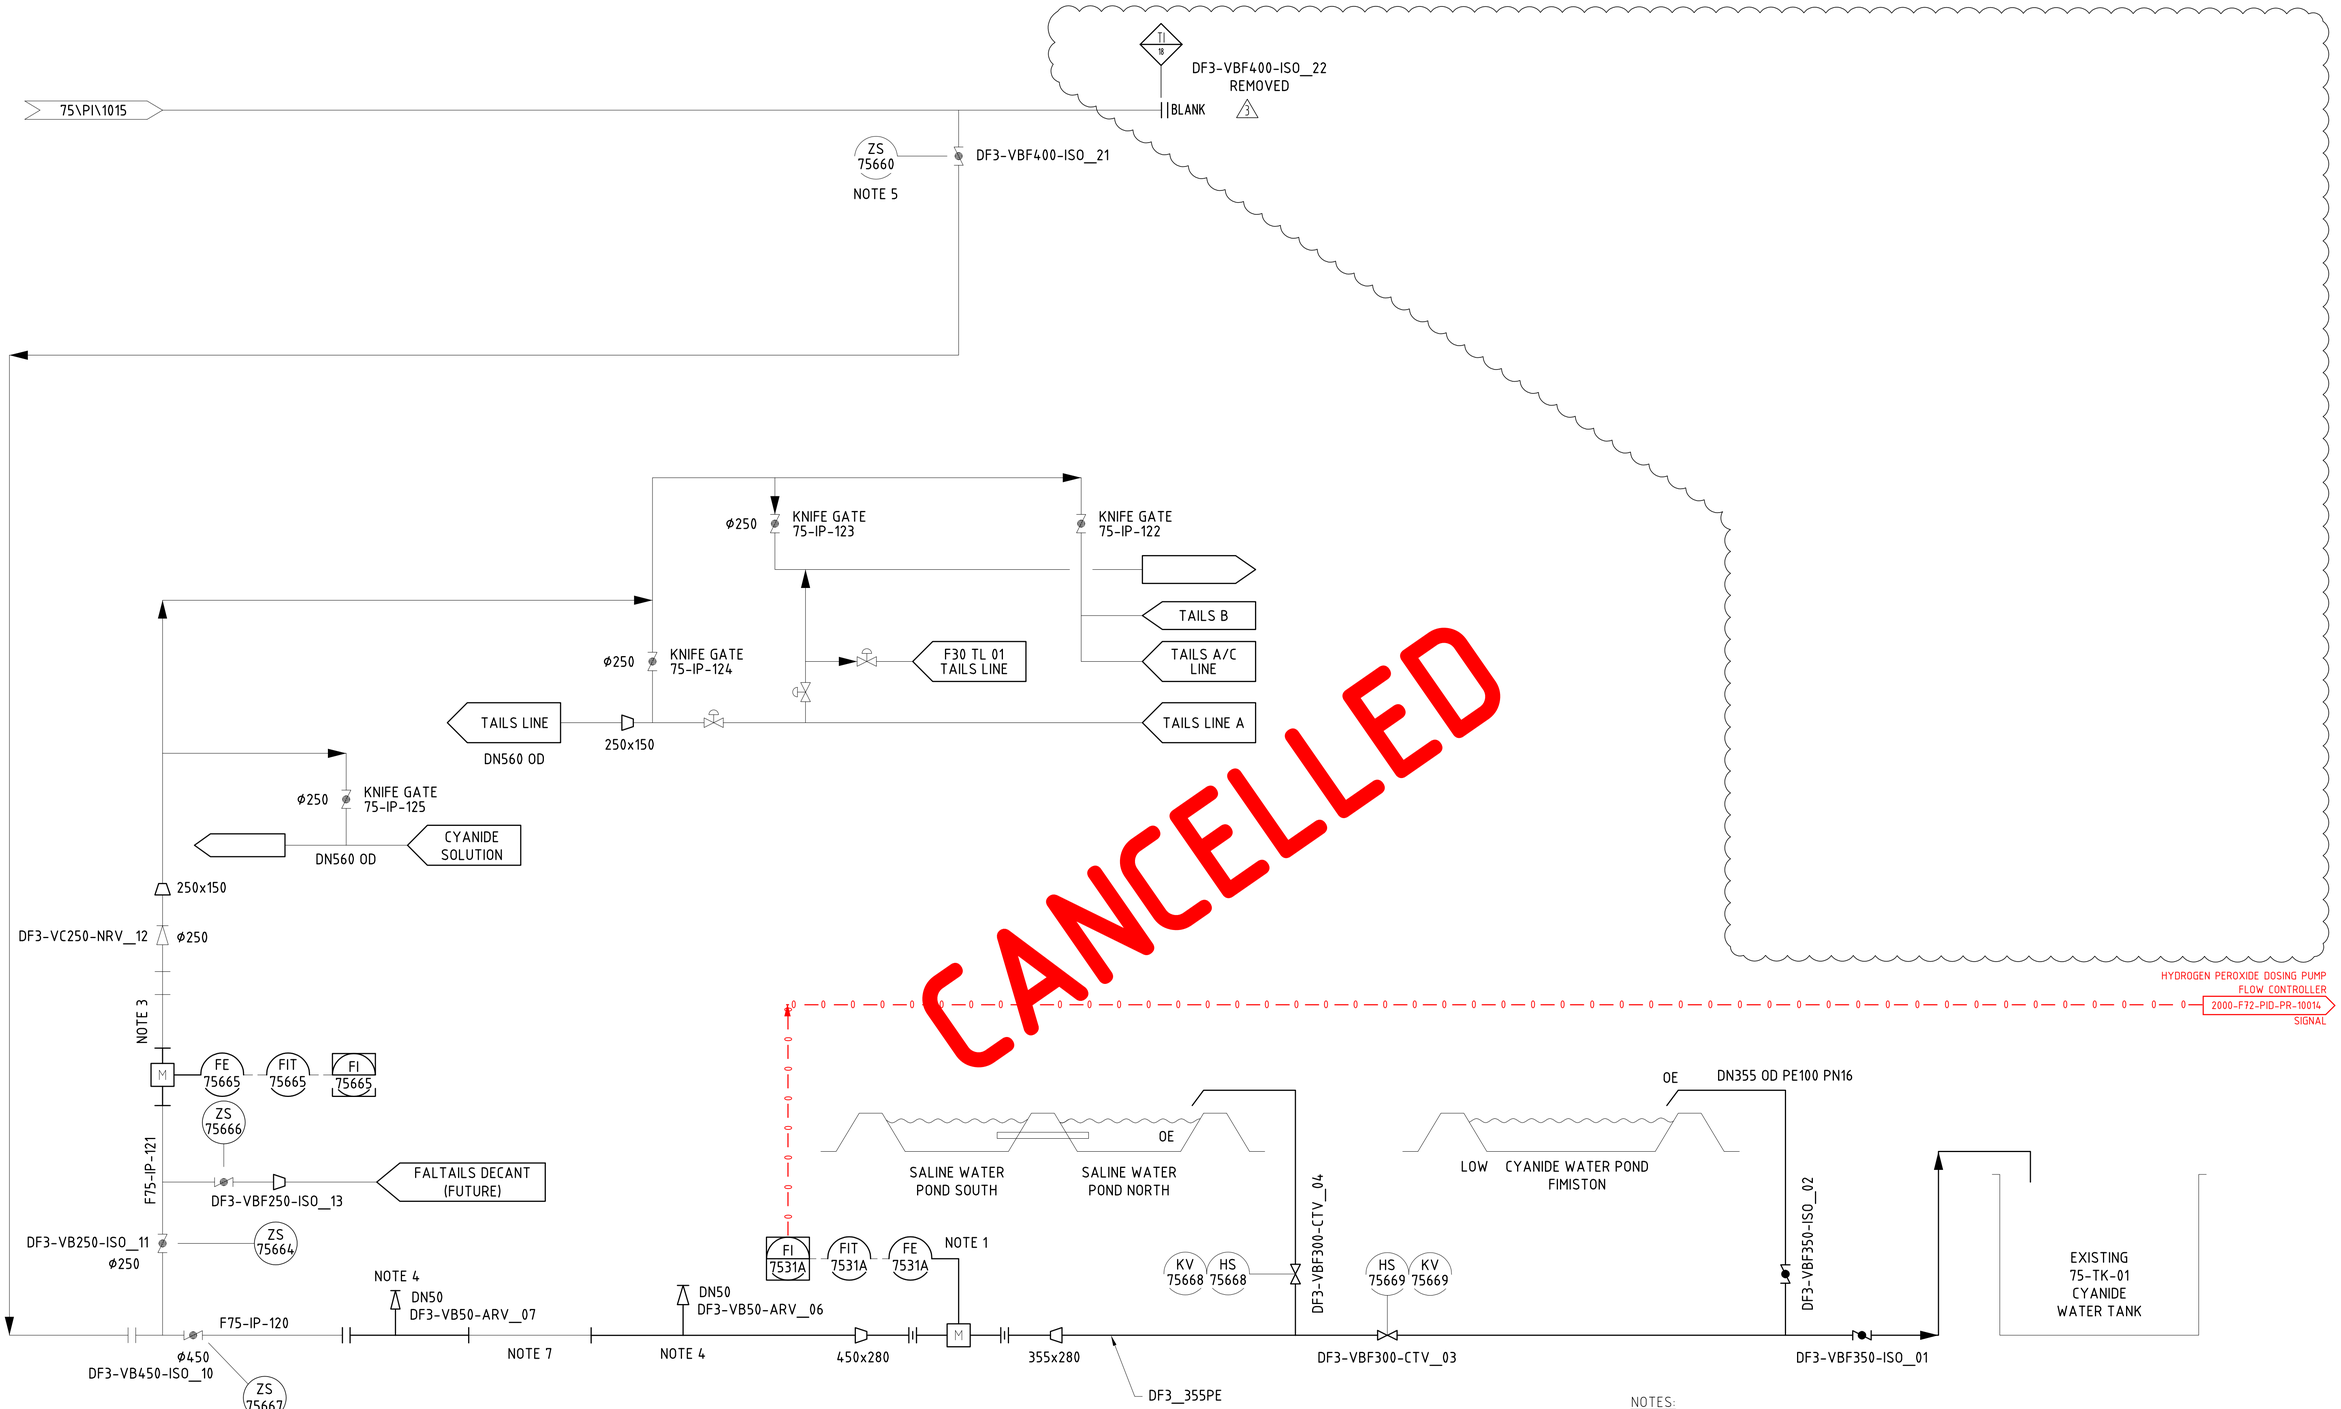


KCGM GROWTH PROJECT

DRAWING NO.
2000-F75-PID-PR-10004

REV	DATE	DESCRIPTION	TECH	APP
C	31MAR25	CANCELLED	[redacted]	[redacted]
B	12MAR24	ISSUED FOR CLIENT REVIEW		
A	05MAR24	ISSUED FOR INTERNAL REVIEW		

LEGEND

- STAGE 1 - NEW
- STAGE 1 - REMOVE
- STAGE 1 - DECOMMISSIONED (OTHERS)
- STAGE 2 - NEW
- 2 - REMOVE
- 2 - DECOMMISSIONED (OTHERS)

NOTES:

1. REUSE EXISTING FLOWMETER.
2. ALL VALVES ARE PREFIXED WITH "F75DCW3". FOR PURPOSES OF CLARITY THIS WILL BE OMITTED FROM P&ID.
3. LOW CYANIDE WATER FLUSHING DUTIES
4. VENT VALVE TO BE POSITIONED AT HIGH POINT SOUTH OF DAMS.
5. POSITIONERS TO BE ADDED TO MANUAL VALVES 450 F2KV01H & F2KV01G
6. EXISTING BUTTERFLY VALVES TO BE RESITED UPSTREAM OF NEW TIE PIECE & KNIFE GATE VALVE
7. REUSE EXISTING SECTION OF DN450 PN16 PE100 HDPE PIPE (BURIED).

MK	DATE	REVISION	BY	CKD	APP
3	06/04/18	FIM II BOOSTER STATION MODIFICATIONS	[redacted]		
2	07/07/17	FINAL AS BUILT		JS	
1	28/06/17	AS BUILT		JS	
0	2016-10-19	ISSUED FOR CONSTRUCTION		AB	

REFERENCE DRAWINGS	DWG NO.
STANDARD DRAWING - STANDARD PIPING - ABBREVIATIONS, DRAWING NUMBERING & BASIC VALVE SYMBOLS	00\SP\1003

SCALE	NTS	
DRAWN	[redacted]	20/07/16
DESIGNED		20/07/16
CHECKED		
APPROVED		
PROJ APP		
PROJ FILE #	K417746	

FIMISTON PLANT
WATER TREATMENT FIMISTON KALTAILS
DECANT DAM 3 PUMP UPGRADE
PROCESS & INSTRUMENT DIAGRAM

SIZE	DRAWING NUMBER	REV
A1	75\PI\1016	3

KALGOORLIE CONSOLIDATED GOLD MINES PTY. LTD. ABN 009 377 619 003