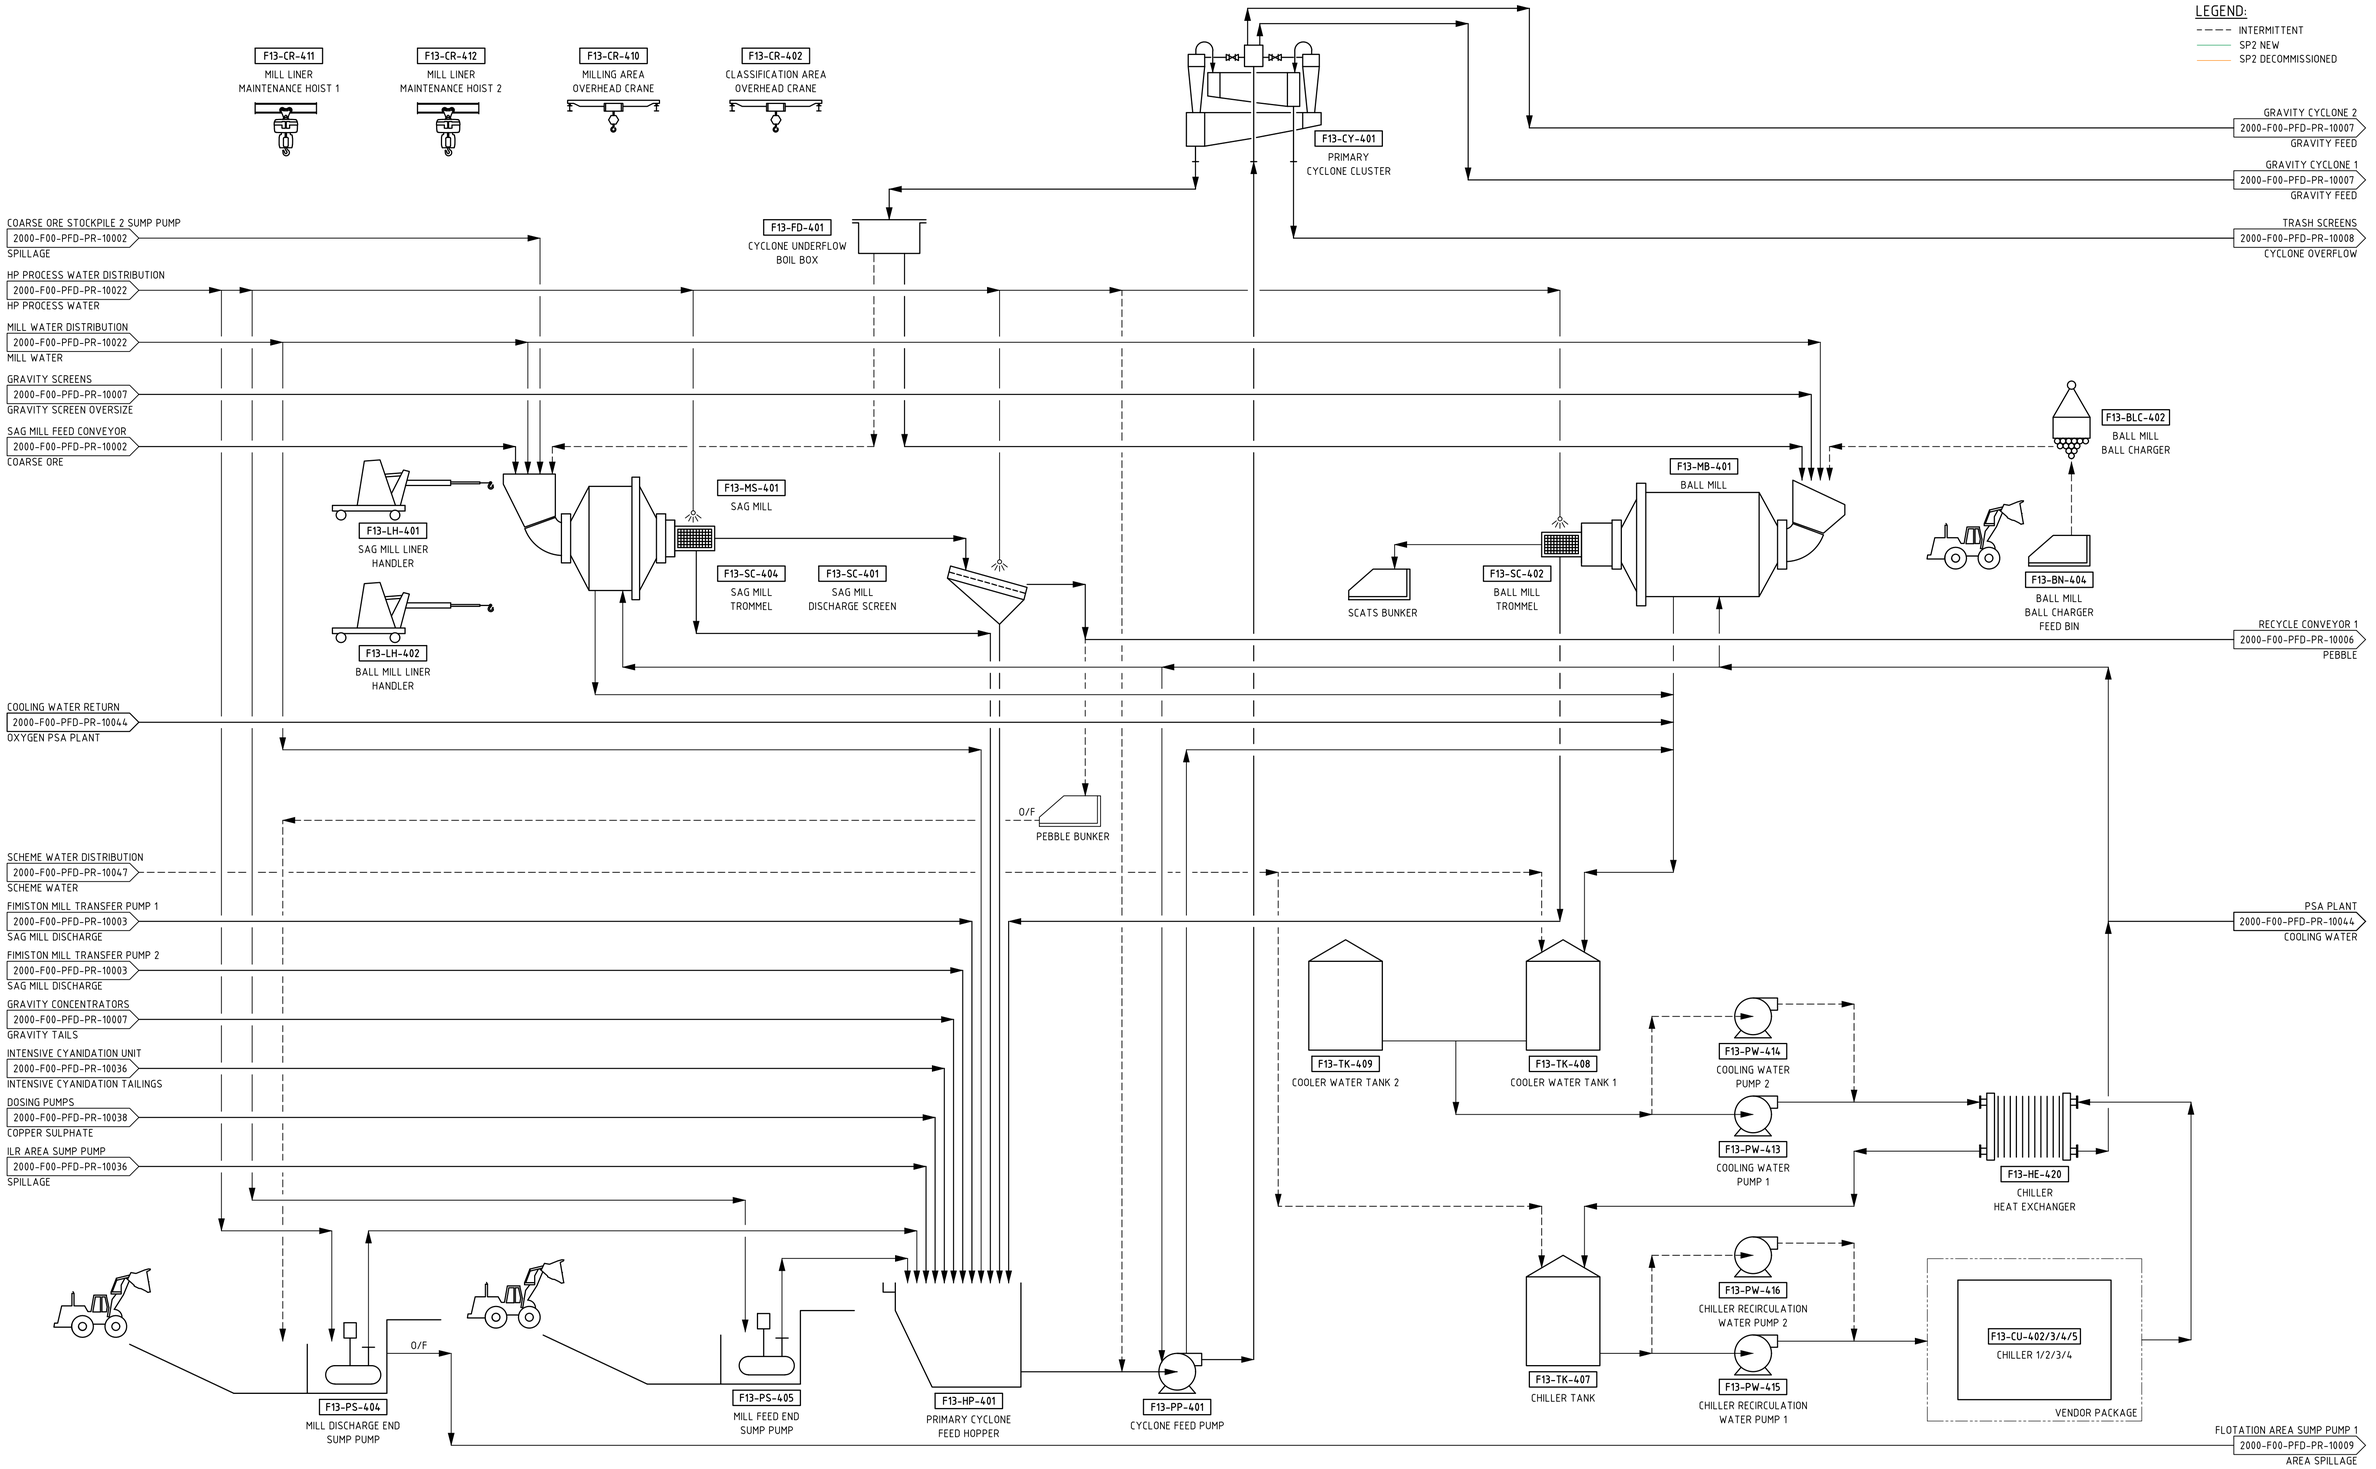


DRG No.	REFERENCES
2000-F00-PID-PR-10007	LEGEND SHEET 7 - PIPING AND INSTRUMENTATION DIAGRAM
2000-F00-PID-PR-10006	LEGEND SHEET 6 - PIPING AND INSTRUMENTATION DIAGRAM
2000-F00-PID-PR-10005	LEGEND SHEET 5 - PIPING AND INSTRUMENTATION DIAGRAM
2000-F00-PID-PR-10004	LEGEND SHEET 4 - PIPING AND INSTRUMENTATION DIAGRAM
2000-F00-PID-PR-10003	LEGEND SHEET 3 - PIPING AND INSTRUMENTATION DIAGRAM
2000-F00-PID-PR-10002	LEGEND SHEET 2 - PIPING AND INSTRUMENTATION DIAGRAM
2000-F00-PID-PR-10001	LEGEND SHEET 1 - PIPING AND INSTRUMENTATION DIAGRAM

REV	DATE	DESCRIPTION	DRAW	CHECK	DESIGN	TECH APP	PROJ APP
1	04SEP26	SP1 AS BUILT					
0	10APR25	ISSUED FOR DESIGN					

NORTHERN STAR RESOURCES LIMITED

PRIMERO
primero.com.au | DESIGN | CONSTRUCT | OPERATE

PRIMERO PROJECT NUMBER: 23517

INFORMATION AND REPRESENTATIONS ON THIS DRAWING ARE THE INTELLECTUAL PROPERTY OF PRIMERO UNLESS SPECIFICALLY IDENTIFIED OTHERWISE. ALL RIGHTS INCLUDING USE RESERVED

PROJECT: NORTHERN STAR RESOURCES LTD
KCGM GROWTH PROJECT

TITLE: SAG & BALL MILLING
PROCESS FLOW DIAGRAM

SHEET	SCALE	DRG No.	REVISION
A1	N.T.S.	2000-F00-PFD-PR-10005	1

O:\CAD PROJECTS\235 NORTHERN STAR RESOURCES LTD\23517 KCGM GROWTH PROJECT\03 DELIVERABLES\PRIMERO\AS BUILT\2000-F00-PFD-PR-10005.DWG 03SEP26 3:22PM ANNE.HOYNE