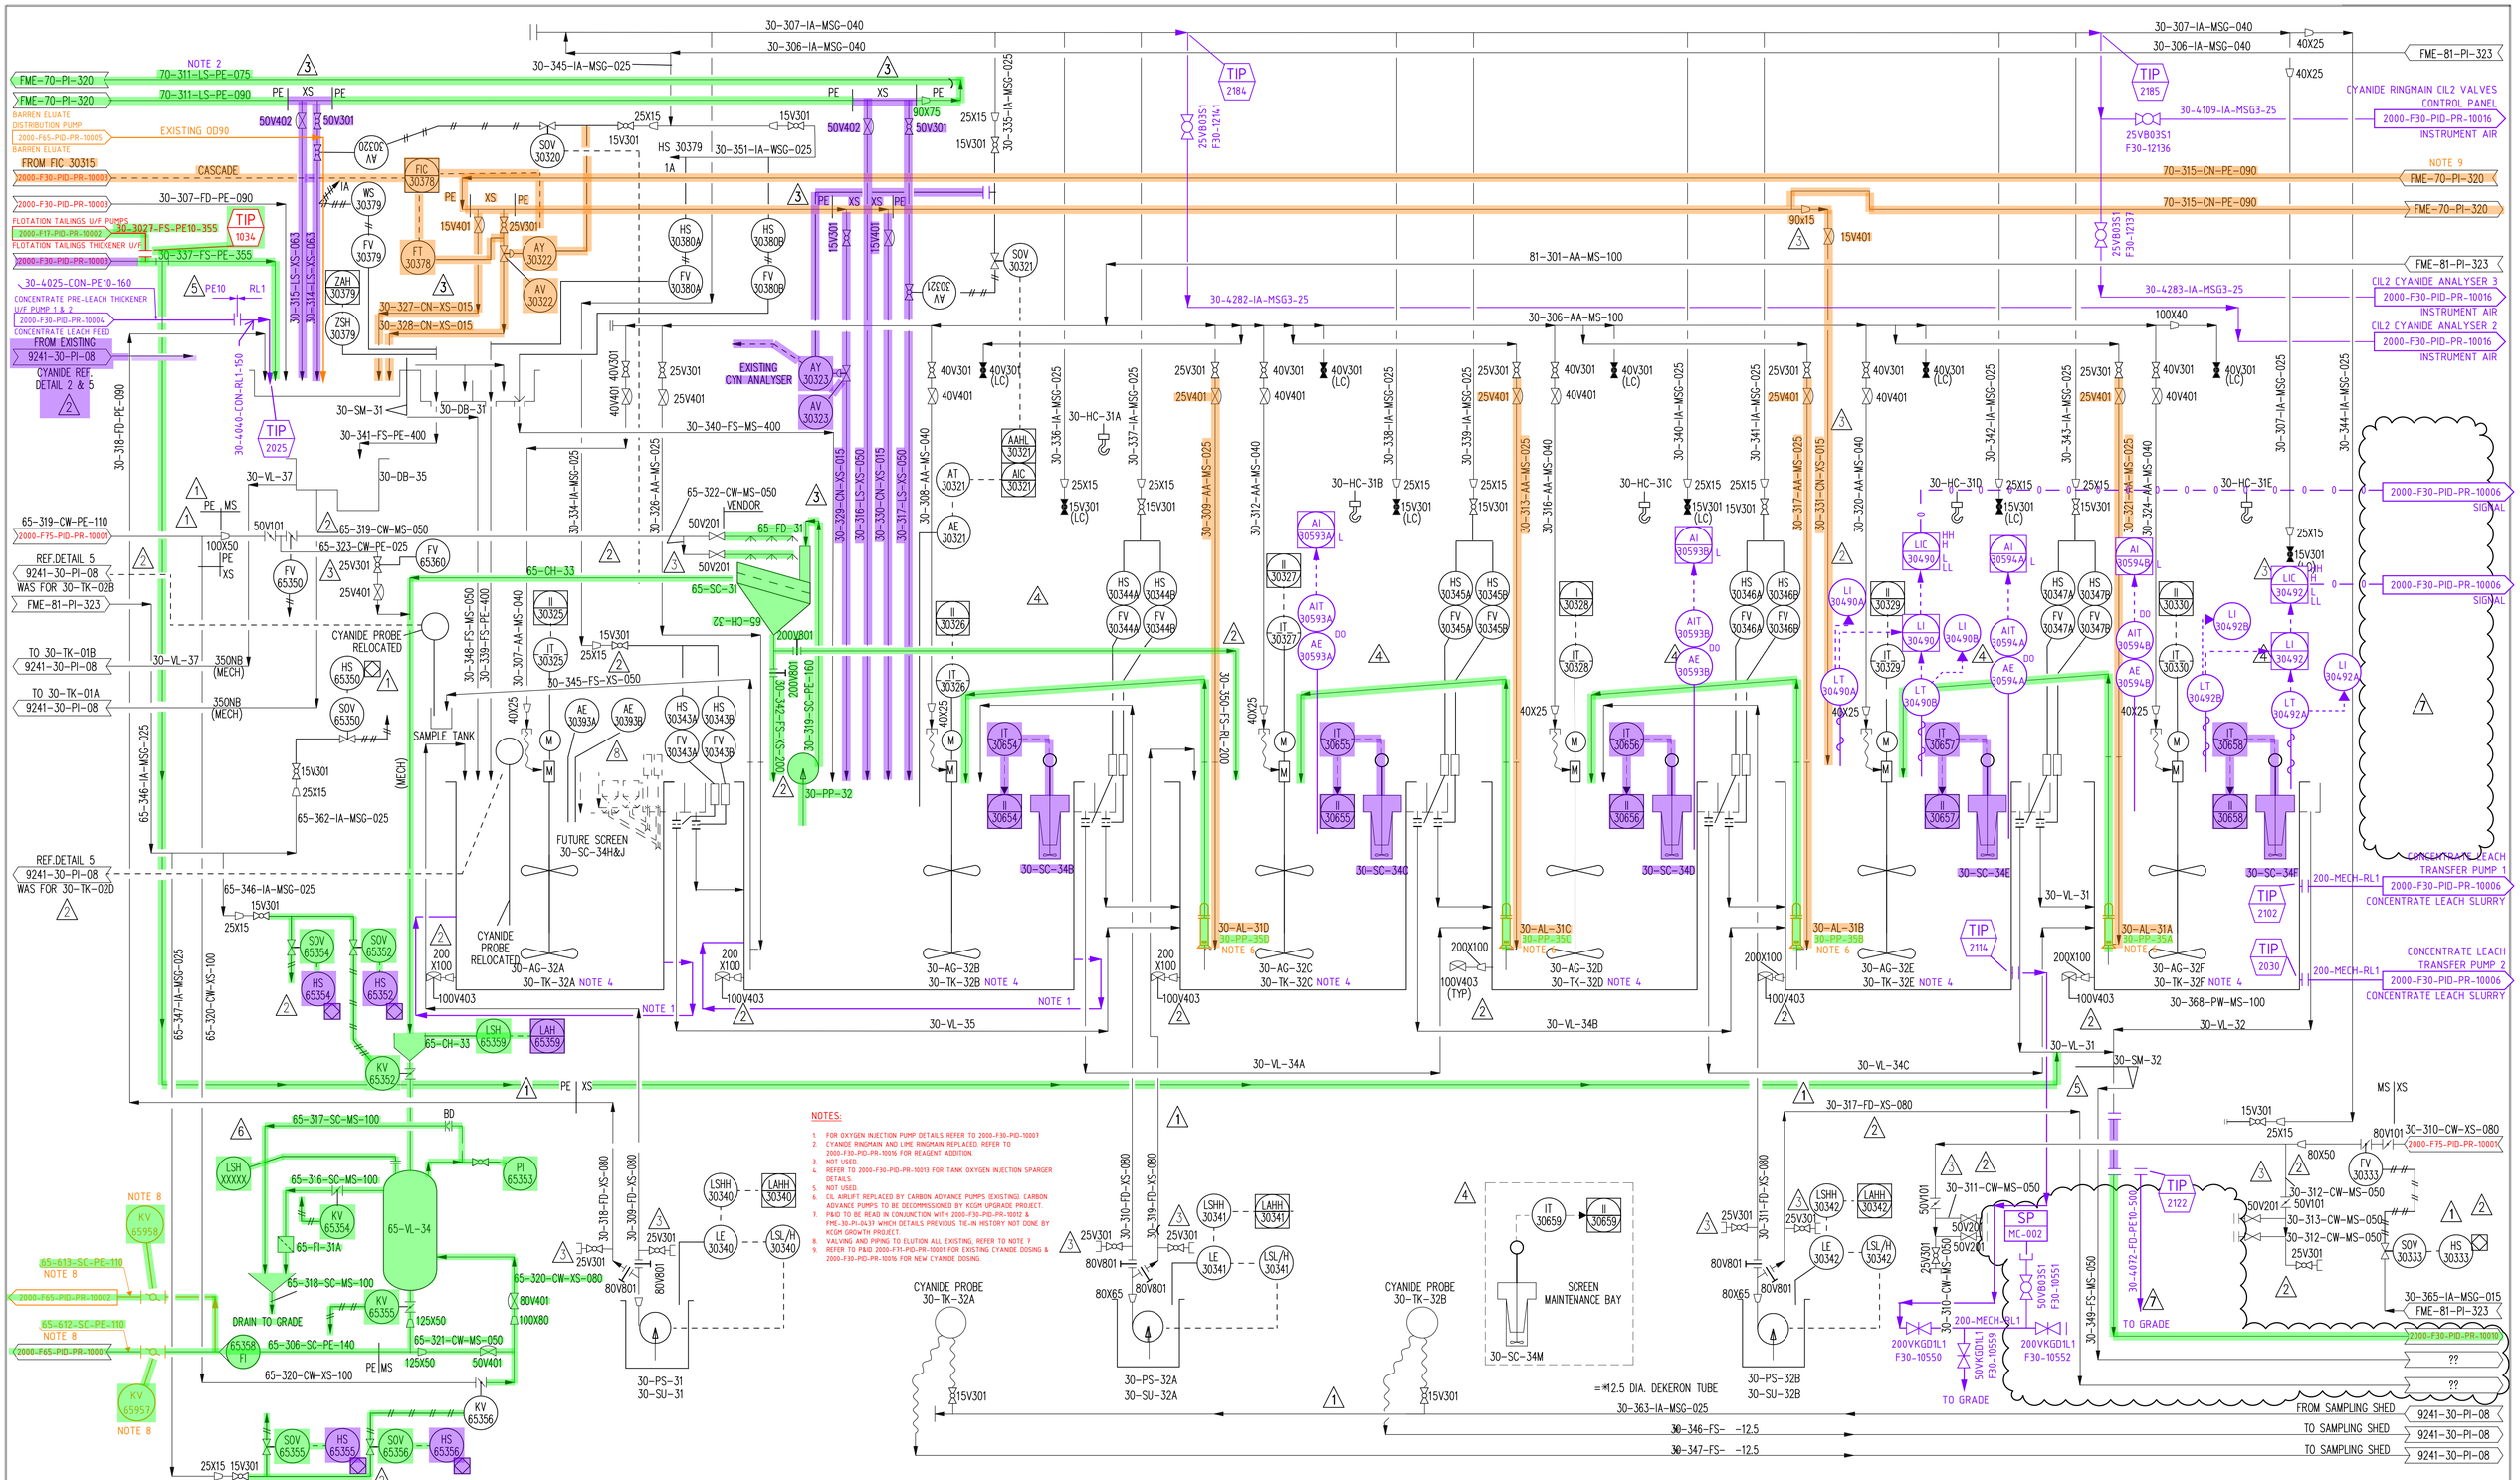


FME-65-PI-319	P & ID – CARBON TREATMENT REGENERATION KILN
FME-70-PI-320	P & ID – REAGENTS AREA
FME-81-PI-323	P & ID – AIR & FUEL SERVICESCATION
FME-00/P-301	PIPING KEY PLAN
FME-00/SP-03	EQUIPMENT SYMBOLS
FME-00/SP-04	P & ID SYMBOLS
DRAWING No.	REFERENCE DRAWINGS

COPYRIGHT ©
This drawing remains the property of MINPROC ENGINEERS PTY. LTD. and may not be copied in any way without prior written approval from this company.

MINPROC ENGINEERS PTY. LTD.
22 STIRLING HIGHWAY, NEDLANDS, W.A. 6009
TELEPHONE : 389 1655

No.	BY	DATE	REVISION	CHECKED	APPRVD.
8	RH	23.11.21	TK32A pH AE30393A & DO AE30393B	K.P.	K.P.
7	LW	31.03.20	CIL BYPASS LINE ADDED	T.R.	
6	JB	02.08.17	BURST DISC ADDES; LINE MODIFIED; LSH ADDED		
5	DL	25.09.01	CIL BYPASS LINE ADDED		
4	TRPL	6/97	INTERSTAGE SCREEN UPGRADE		
			FIMISTON CONSOLIDATED PROJECT 1997		

No.	BY	DATE	REVISION	CHECKED	APPRVD.
3	FW	03.09.91	AS BUILT		
2	EAC	13.05.91	REVISED AS NOTED	P.B.	D.T.
1	DC	08.04.91	LINES 363&5-IA,316/7-FS,	P.B.	B.R.
			318/9-FD ADDED.SPEC XS WAS MS		
0	DC	26.03.91	ISSUED FOR CONSTRUCTION	P.B.	B.R.
B	DC	15.02.91	ISSUED FOR TENDER	P.B.	D.T.
A	T.S.	10.12.90	ISSUED FOR APPROVAL		

	BY	DATE
PROJECT APPR.	F MOUTINHO	12/3/91
DESIGN APPR.	D TAYLOR	12/3/91
DESIGNED	B RUGGIERO	12/3/91
CHECKED	P BARRY	12/3/91
DRAWN	T.SMITH	11/90

PLANT GRID NORTH

CLIENT: KALGOORLIE CONSOLIDATED GOLD MINES

SIZE: B1 SCALE: N.T.S.

TITLE: FIMISTON CONSOLIDATED PROJECT 1997
PIPING & INSTRUMENTATION DIAGRAM
LEACH & ADSORPTION – CIL No.2

REV. No. A 8 0 1 2 3 4 5 6 7 8

DRAWING No. FME-30-PI-0313