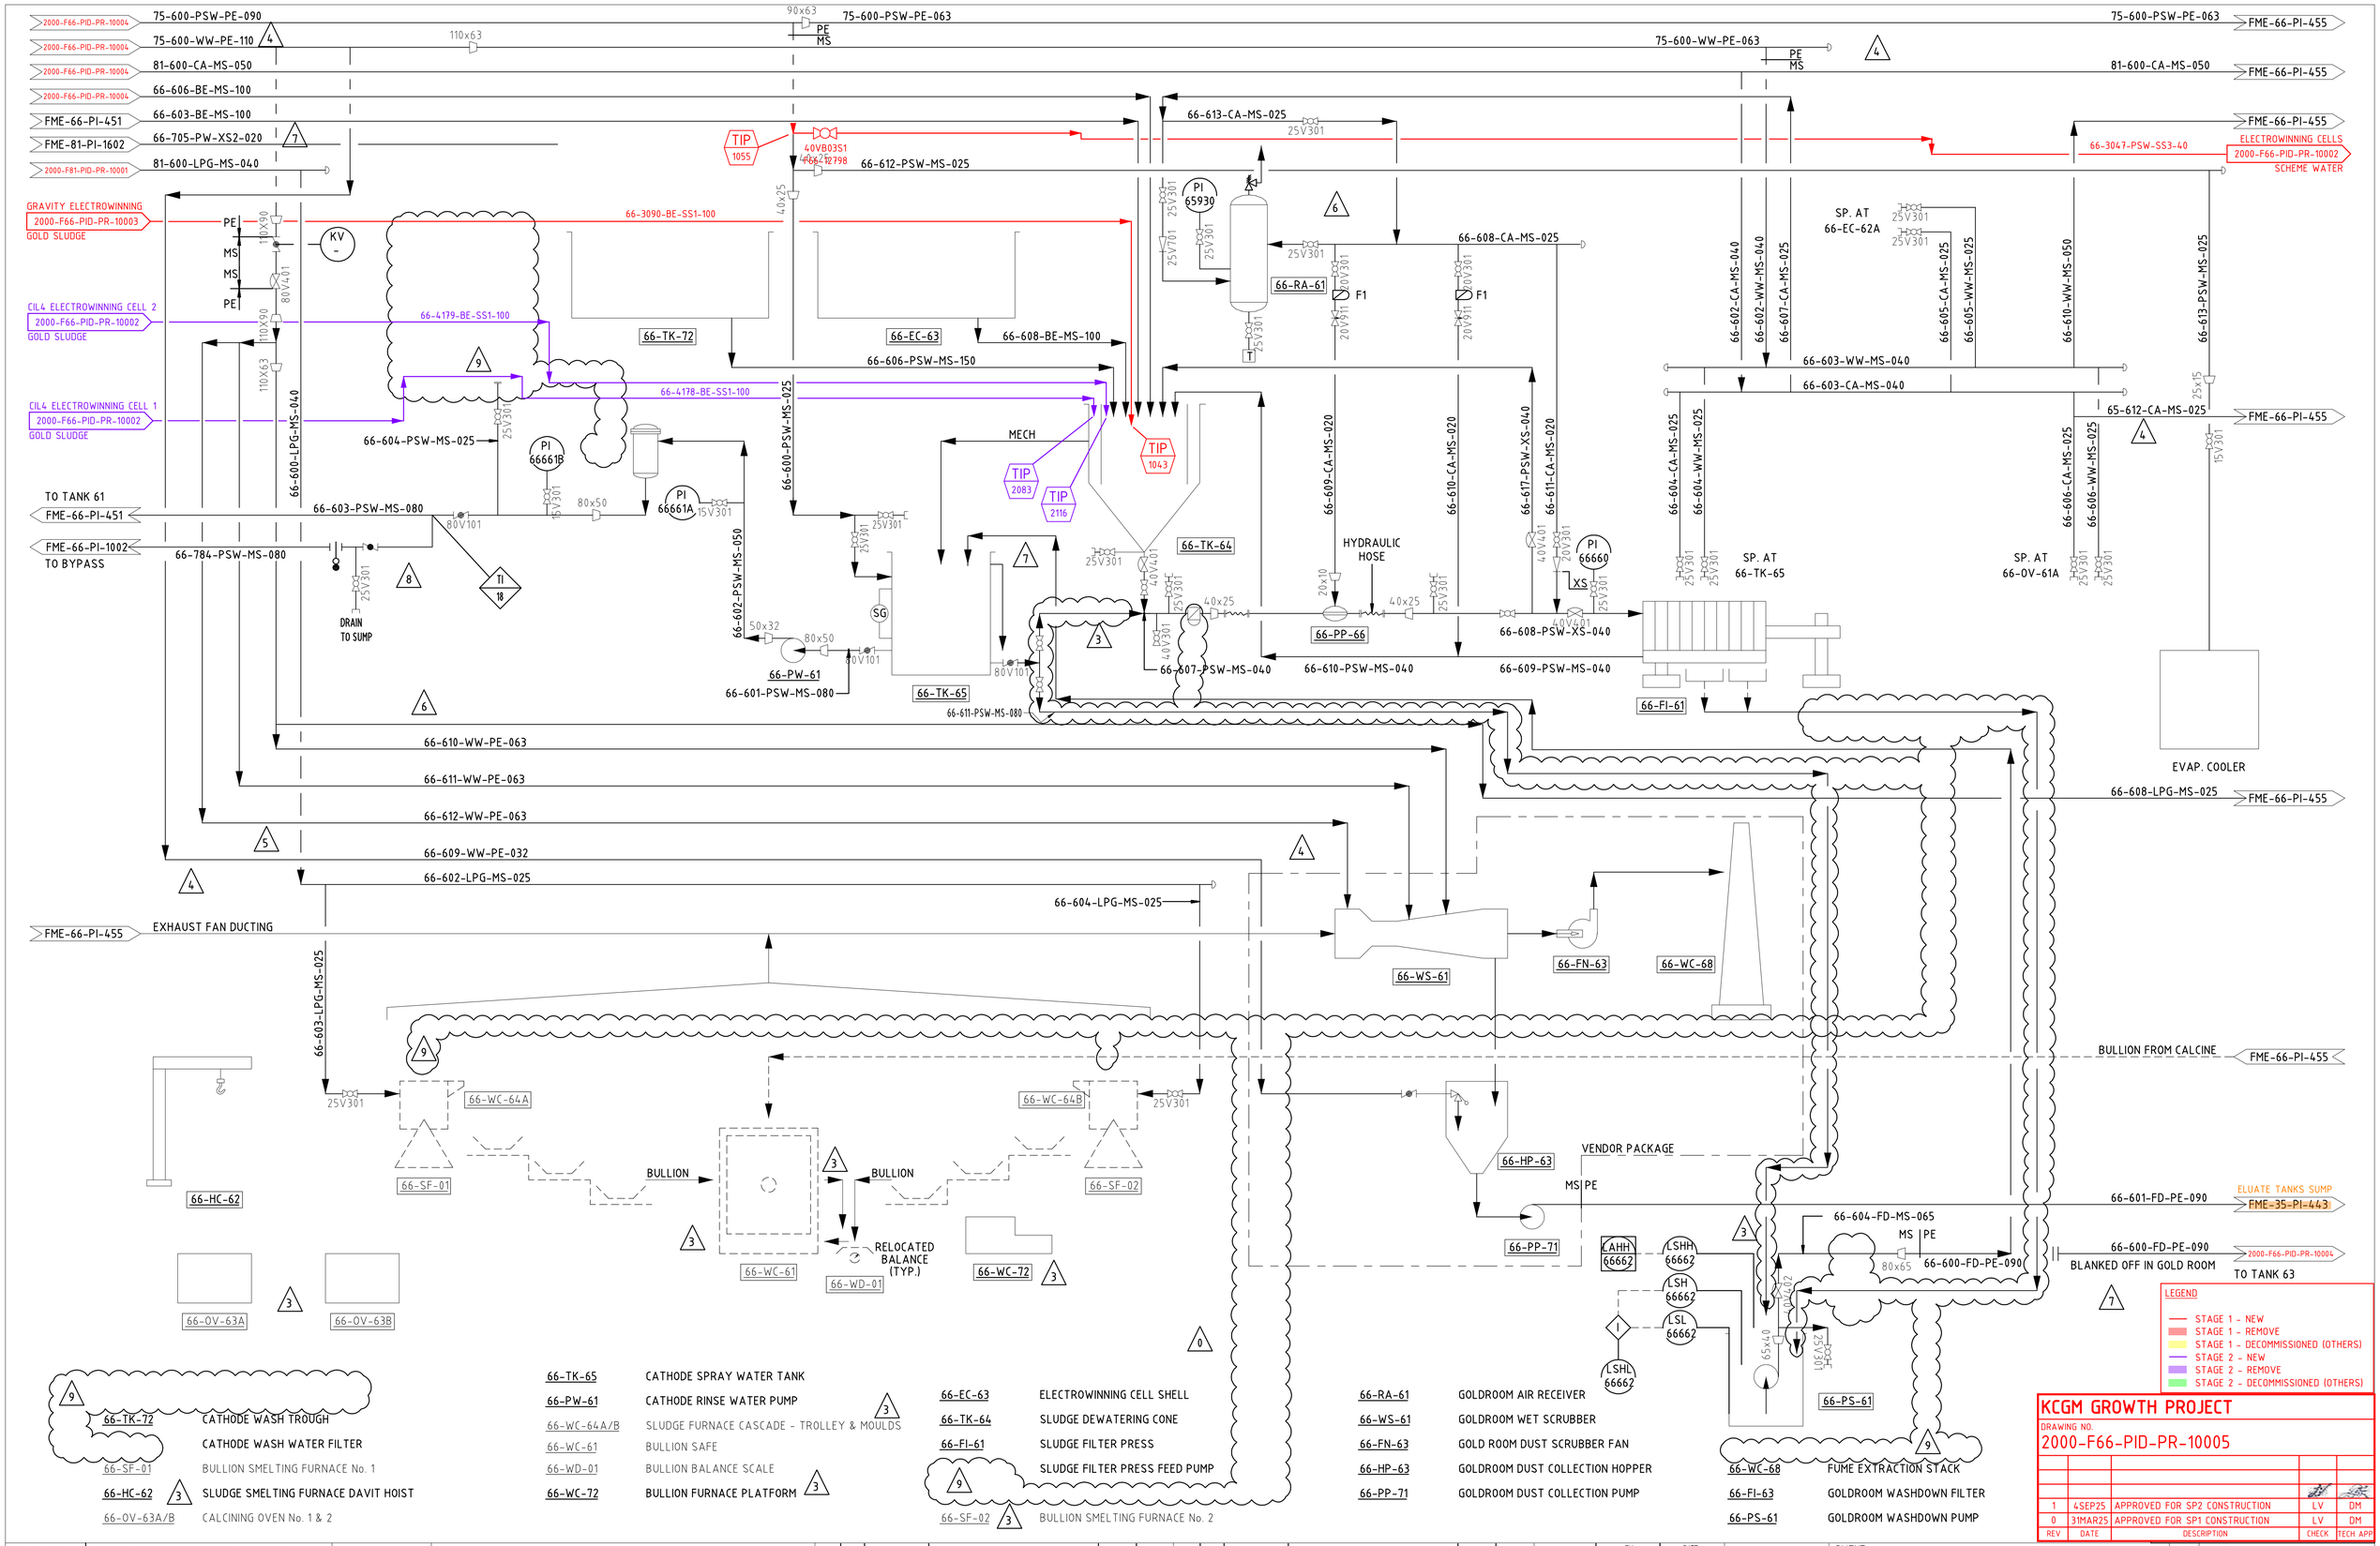



| | | | |
|---|---|---|---|
| 66-TK-65 | CATHODE SPRAY WATER TANK | 66-EC-63 | ELECTROWINNING CELL SHELL |
| 66-PW-61 | CATHODE RINSE WATER PUMP | 66-TK-64 | SLUDGE DEWATERING CONE |
| 66-WC-64A/B | SLUDGE FURNACE CASCADE - TROLLEY & MOULDS | 66-FI-61 | SLUDGE FILTER PRESS |
| 66-WC-61 | BULLION SAFE | | SLUDGE FILTER PRESS FEED PUMP |
| 66-WD-01 | BULLION BALANCE SCALE | 66-SF-02 | BULLION SMELTING FURNACE No. 2 |
| 66-WC-72 | BULLION FURNACE PLATFORM | | |

| | | | |
|---|---|---|---|
| 66-RA-61 | GOLDROOM AIR RECEIVER | 66-WC-68 | FUME EXTRACTION STACK |
| 66-WS-61 | GOLDROOM WET SCRUBBER | 66-FI-63 | GOLDROOM WASHDOWN FILTER |
| 66-FN-63 | GOLD ROOM DUST SCRUBBER FAN | 66-PS-61 | GOLDROOM WASHDOWN PUMP |
| 66-HP-63 | GOLDROOM DUST COLLECTION HOPPER | | |
| 66-PP-71 | GOLDROOM DUST COLLECTION PUMP | | |

| | |
|---|---|
| 66-TK-72 | CATHODE WASH TROUGH |
| | CATHODE WASH WATER FILTER |
| 66-SF-01 | BULLION SMELTING FURNACE No. 1 |
| 66-HC-62 | SLUDGE SMELTING FURNACE DAVIT HOIST |
| 66-OV-63A/B | CALCINING OVEN No. 1 & 2 |

**KCGM GROWTH PROJECT**

DRAWING NO. 2000-F66-PID-PR-10005

| REV | DATE | DESCRIPTION | CHECK | TECH APP |
|---|---|---|---|---|
| 1 | 4SEP25 | APPROVED FOR SP2 CONSTRUCTION | LV | DM |
| 0 | 31MAR25 | APPROVED FOR SP1 CONSTRUCTION | LV | DM |

| | |
|---|---|
| FME-00-SP-419 | MISCELLANEOUS EQUIPMENT SCHEDULE |
| FME-00-SP-415 | MANUAL VALVE SCHEDULE |
| FME-00-SP-411 | PIPING LINE LIST |
| FME-00-P-401 | PIPING KEYPLAN |
| FME-00-SP-408 | INSTRUMENT STANDARDS |
| FME-00-SP-404 | STANDARD ABBREV. & VALVE SYMBOLS |
| FME-00-SP-403 | STANDARD EQUIPMENT SYMBOLS |
| DRAWING No. | REFERENCE DRAWINGS |

COPYRIGHT ©
This drawing remains the property of MINPROC ENGINEERS LIMITED and may not be copied in any way without prior written approval from this company.

MINPROC ENGINEERS LIMITED
A.C.N. 008 992 694
22, STIRLING HIGHWAY, NEDLANDS WA 6009
PHONE (09) 347 4777

| No. | BY | DATE | REVISION | CHECKED | APPROV. |
|---|---|---|---|---|---|
| 9 | L.W. | 04.05.2020 | EQUIPMENT REMOVED - 'AS BUILT' | T.R. | - |
| 8 | AKU | 6/7/16 | ISSUE FOR TENDER | | |
| 7 | AKU | 19/6/16 | GENERAL UPDATE | | |

| No. | BY | DATE | REVISION | CHECKED | APPROV. |
|---|---|---|---|---|---|
| 6 | SB | 30/5/95 | REVISED AS NOTED | | |
| 5 | PR | 24/5/95 | LN#66-601/605-LPG REMOVED | GT | AH |
| 4 | PR | 19/4/95 | REVISED AS NOTED | GT | EJ |
| 3 | PR | 31/3/95 | REVISED AS NOTED | GT | EJ |
| 2 | PR | 10/2/95 | APPROVED FOR CONSTRUCTION | | |
| 1 | PR | 27/1/95 | RE-ISSUED FOR TENDER | | |
| 0 | PGN | 21/12/94 | APPR. FOR TENDER - F037 | | |

| | BY | DATE |
|---|---|---|
| PROJECT APPR. | D.MARSHALL | 9/3/95 |
| DESIGN APPR. | D.TAYLOR | 3/5/95 |
| DESIGNED | D.TURNER | 20/2/95 |
| CHECKED | G.TORKINGTON | 28/2/95 |
| DRAWN | P.R | 1/8/94 |

PLANT GRID NORTH

CLIENT: KALGOORLIE CONSOLIDATED GOLD MINES

TITLE: FIMISTON EXPANSION 1994/95
PIPING & INSTRUMENT DIAGRAM
GOLD SMELTING

SIZE: B1 | SCALE: N.T.S.

REV. No.: 0 1 2 3 4 5 6 7 8 9

DRAWING No.: 66\Pi\0454