
NOTES:

1. REFER TO P&ID 2000-F75-PID-PR-25003 B-10 FOR TIE-IN, TIP IS BURIED.
2. REFER TO P&ID 2000-F75-PID-PR-25003 J-6 FOR TIE-IN.

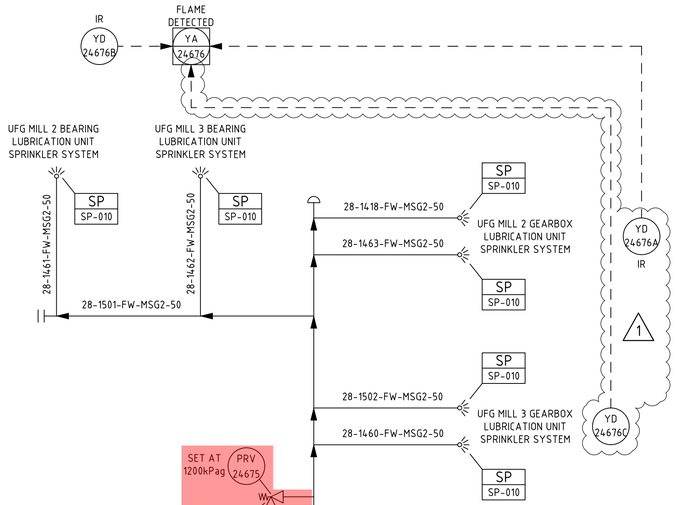



AS CONSTRUCTED

CHANGE: ☐	NO CHANGE: ☑

SIGNATURE:
NAME: Suraj Utture
DATE: 16 / 03 / 2026

ENGINEER SIGN OFF

SIGNATURE:
NAME: Luke Visaggio
DATE: 16 / 03 / 2026

DRG No.	REFERENCES
2000-F00-PID-PR-10007	LEGEND SHEET 7 - PIPING AND INSTRUMENTATION DIAGRAM
2000-F00-PID-PR-10006	LEGEND SHEET 6 - PIPING AND INSTRUMENTATION DIAGRAM
2000-F00-PID-PR-10005	LEGEND SHEET 5 - PIPING AND INSTRUMENTATION DIAGRAM
2000-F00-PID-PR-10004	LEGEND SHEET 4 - PIPING AND INSTRUMENTATION DIAGRAM
2000-F00-PID-PR-10003	LEGEND SHEET 3 - PIPING AND INSTRUMENTATION DIAGRAM
2000-F00-PID-PR-10002	LEGEND SHEET 2 - PIPING AND INSTRUMENTATION DIAGRAM
2000-F00-PID-PR-10001	LEGEND SHEET 1 - PIPING AND INSTRUMENTATION DIAGRAM

REV	DATE	DESCRIPTION	DRAW	CHECK	DESIGN	TECH APP	PROJ APP
RL1	16MAR26	AS CONSTRUCTED FOR F24.90.06	AH	MM	JBe	LV	DM
1	12SEP25	GENERAL REVISIONS ADDED	AH	MM	JBe	LV	DM
0	06JAN25	APPROVED FOR CONSTRUCTION	NB	JDM	LS	LV	DM

NORTHERN STAR RESOURCES LIMITED

PRIMERO
primero.com.au | DESIGN | CONSTRUCT | OPERATE
PRIMERO PROJECT NUMBER: 23517

INFORMATION AND REPRESENTATIONS ON THIS DRAWING ARE THE INTELLECTUAL PROPERTY OF PRIMERO UNLESS SPECIFICALLY IDENTIFIED OTHERWISE. ALL RIGHTS INCLUDING USE RESERVED

PROJECT: NORTHERN STAR RESOURCES LTD
KCGM GROWTH PROJECT

TITLE: AIR & WATER SERVICES
FIRE WATER - SHEET 2
PIPING AND INSTRUMENTATION DIAGRAM

SHEET	SCALE	DRG No.	REVISION
A1	NTS	2000-F24-PID-PR-10015	1RL1

D:\CAD PROJECTS\235 NORTHERN STAR RESOURCES LTD\235.17 KCGM GROWTH PROJECT\03 DELIVERABLES\PDR\PID\ISSUED\12.09.25 - SIGNING\NATIVES\2000-F24-PID-PR-10015_1DWG 10SEP25 10:58AM ANNE.HOYNE