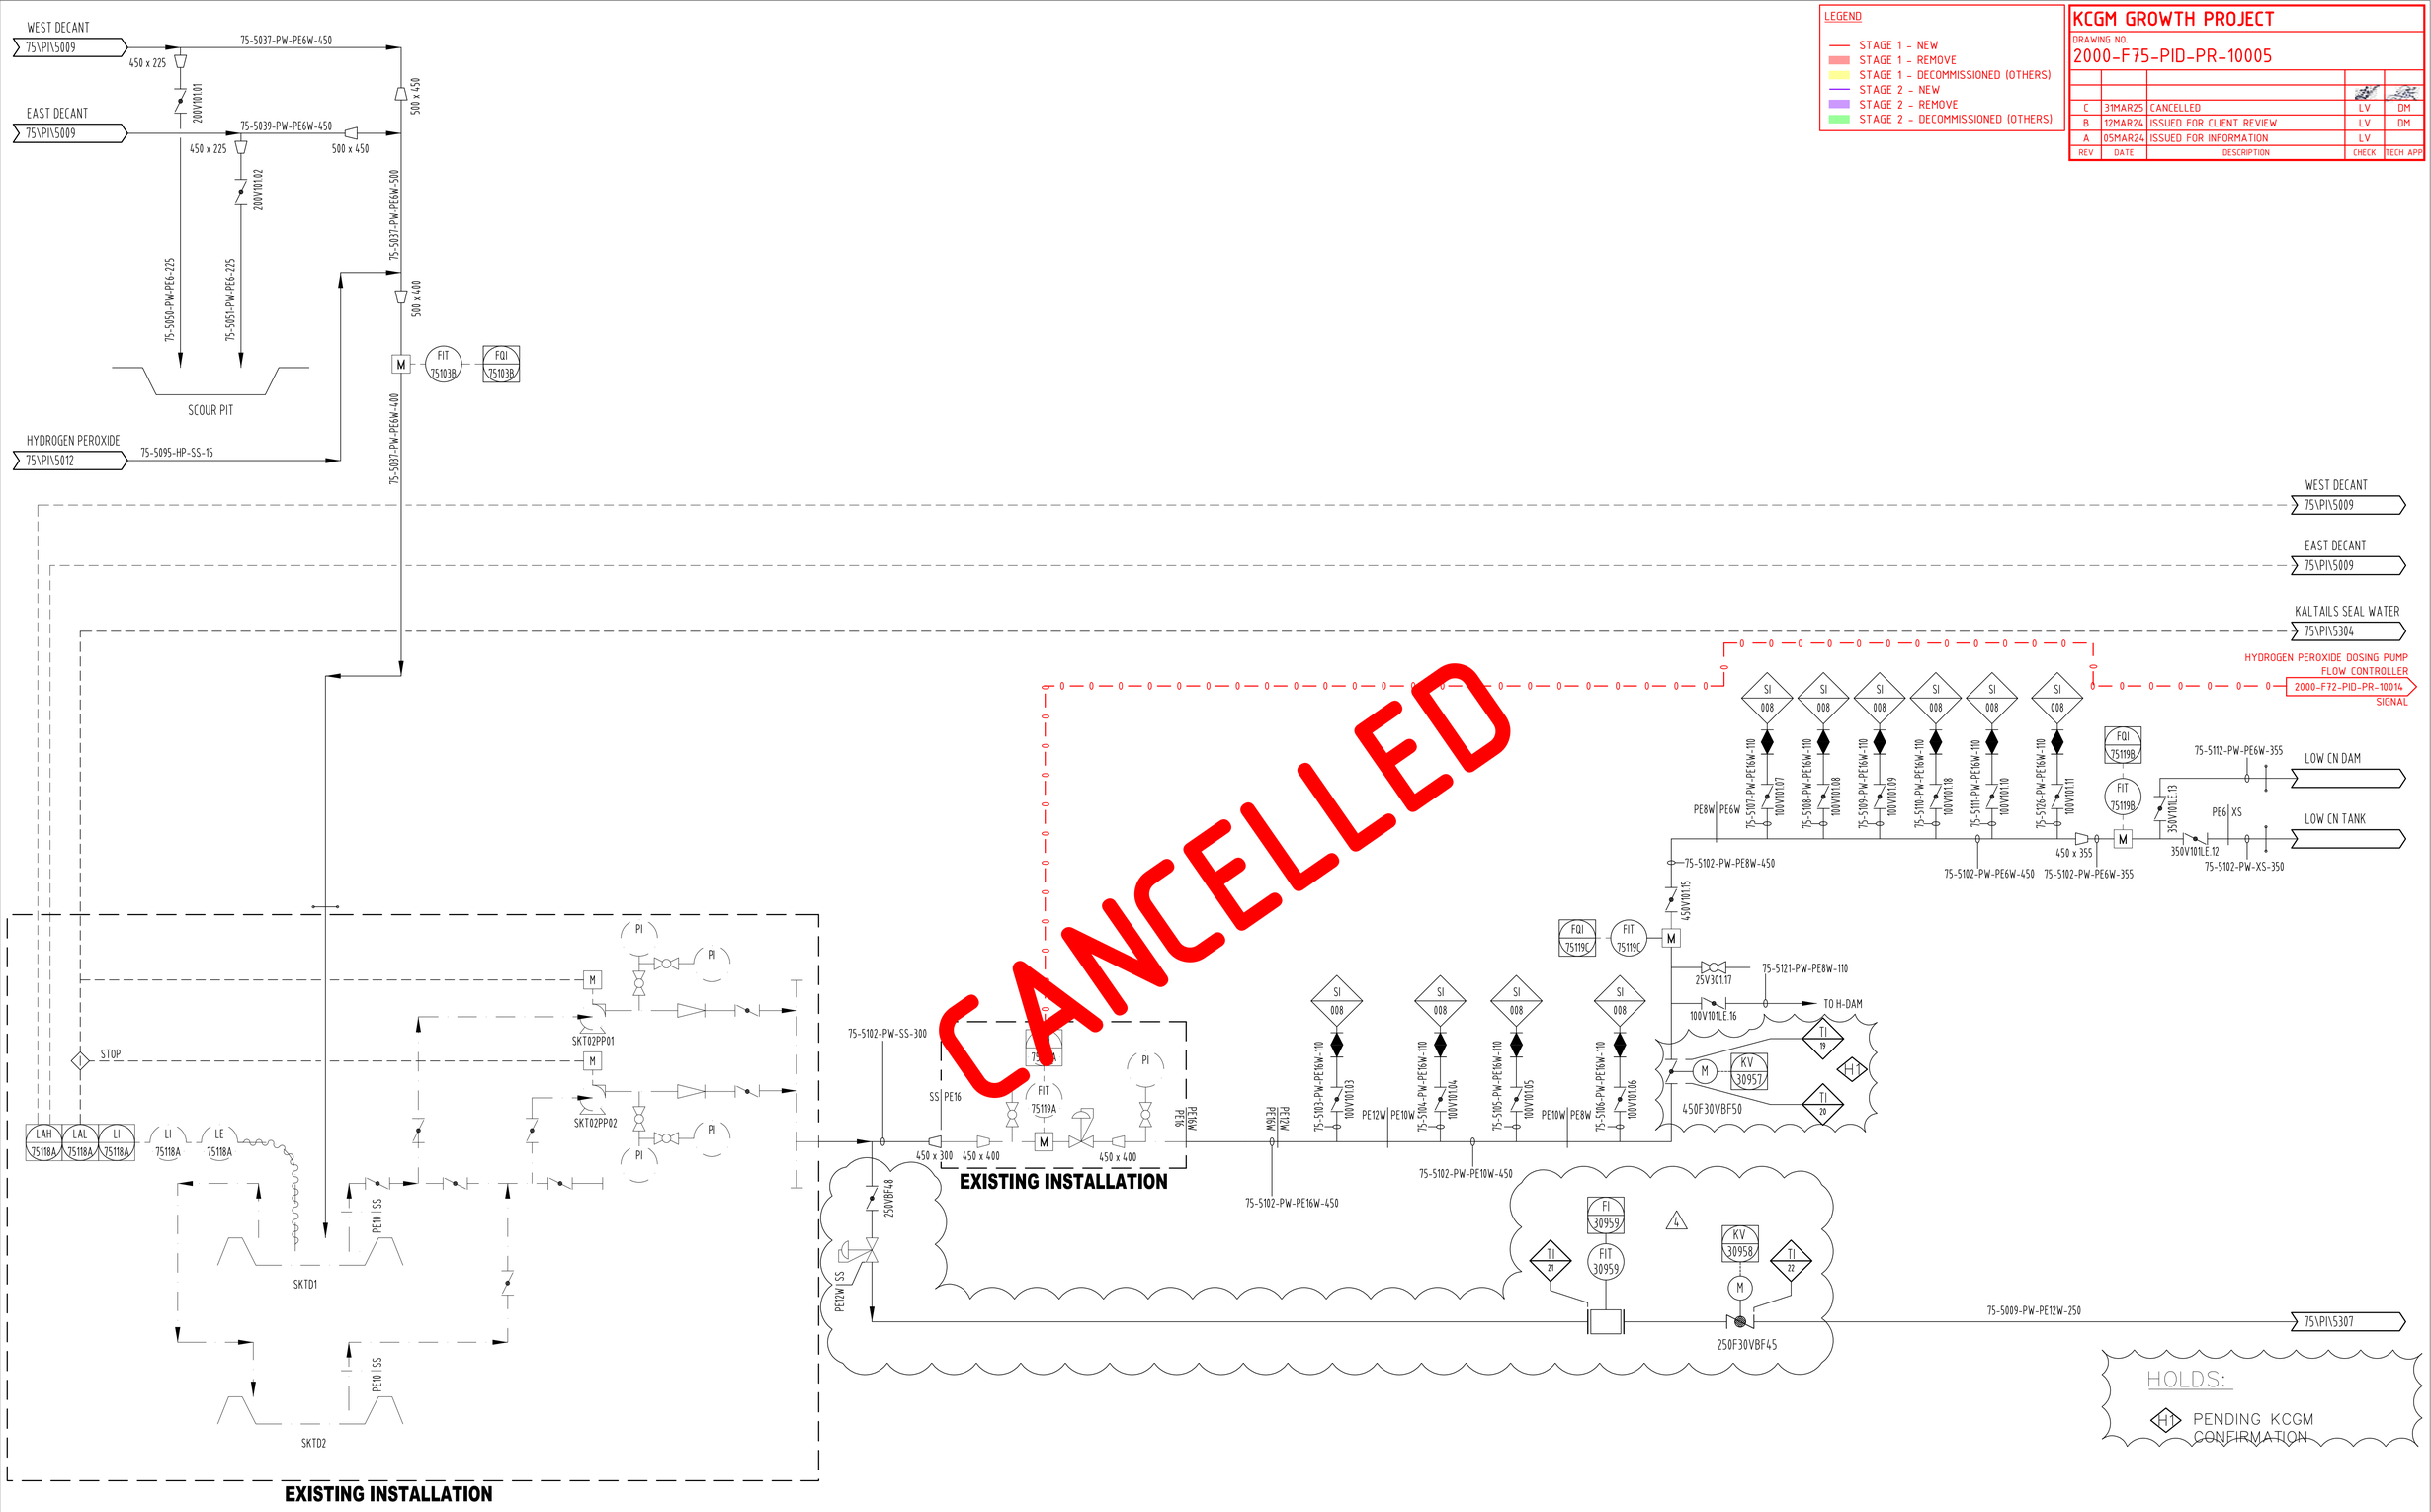


LEGEND

- STAGE 1 - NEW
- STAGE 1 - REMOVE
- STAGE 1 - DECOMMISSIONED (OTHERS)
- STAGE 2 - NEW
- STAGE 2 - REMOVE
- STAGE 2 - DECOMMISSIONED (OTHERS)

KCGM GROWTH PROJECT

DRAWING NO.
2000-F75-PID-PR-10005

REV	DATE	DESCRIPTION	CHECK	TECH APP
C	31MAR25	CANCELLED	LV	DM
B	12MAR24	ISSUED FOR CLIENT REVIEW	LV	DM
A	05MAR24	ISSUED FOR INFORMATION	LV	

MK	DATE	REVISION	BY	CKD	APP
4	3 SEPT 2019	250F30VBF48 ADDED, HOLD 2 REMOVED	ME	IW	
3	22 AUG 2019	HOLDS ADDED, AND UPDATED TO REFLECT SITE PHOTOS	ME	JMC	
2	6 APRIL 2018	KALTAILS BOOSTER STATION MODIFICATIONS	JM		
1	15 NOV 2012	ISSUED FOR AS BUILT	GAO	AG	
0		ISSUED FOR CONSTRUCTION			

MK	DATE	REVISION	BY	CKD	ENG CHK	APP

REFERENCE DRAWINGS

DWG NO.

PROJ FILE #

SCALE	NTS	
DRAWN	MAL	2.10.09
DESIGNED		
CHECKED		
APPROVED		
PROJ APP		

SEDGMAN Limited A.B.N. 86 088 471 667 © 2006

SEDGMAN DRG No. 0251-2-2-0012 SEDGMAN JOB No. 0251

FIMISTON PLANT
WATER TREATMENT FIMISTON
KALTAILS TSF RECOMMISSIONING
PIPING & INSTRUMENTATION DIAGRAM - DECANT RETURN

SIZE	DRAWING NUMBER	REV
A1	75\PI\5003	4

KALGOORLIE CONSOLIDATED GOLD MINES PTY. LTD. ABN 009 377 619 083

PLOT DATE 29/07/19 - 11:25:41 - Cad File: P:\A251 - Kaltails Recommissioning\28 CAD\12\A251-2-2-0012.dwg [A251-2-2-0012] - Printed by: mark.lawson