
Docusign Envelope ID: 82598C47-981F-4F0A-82C3-EDD9660347C0

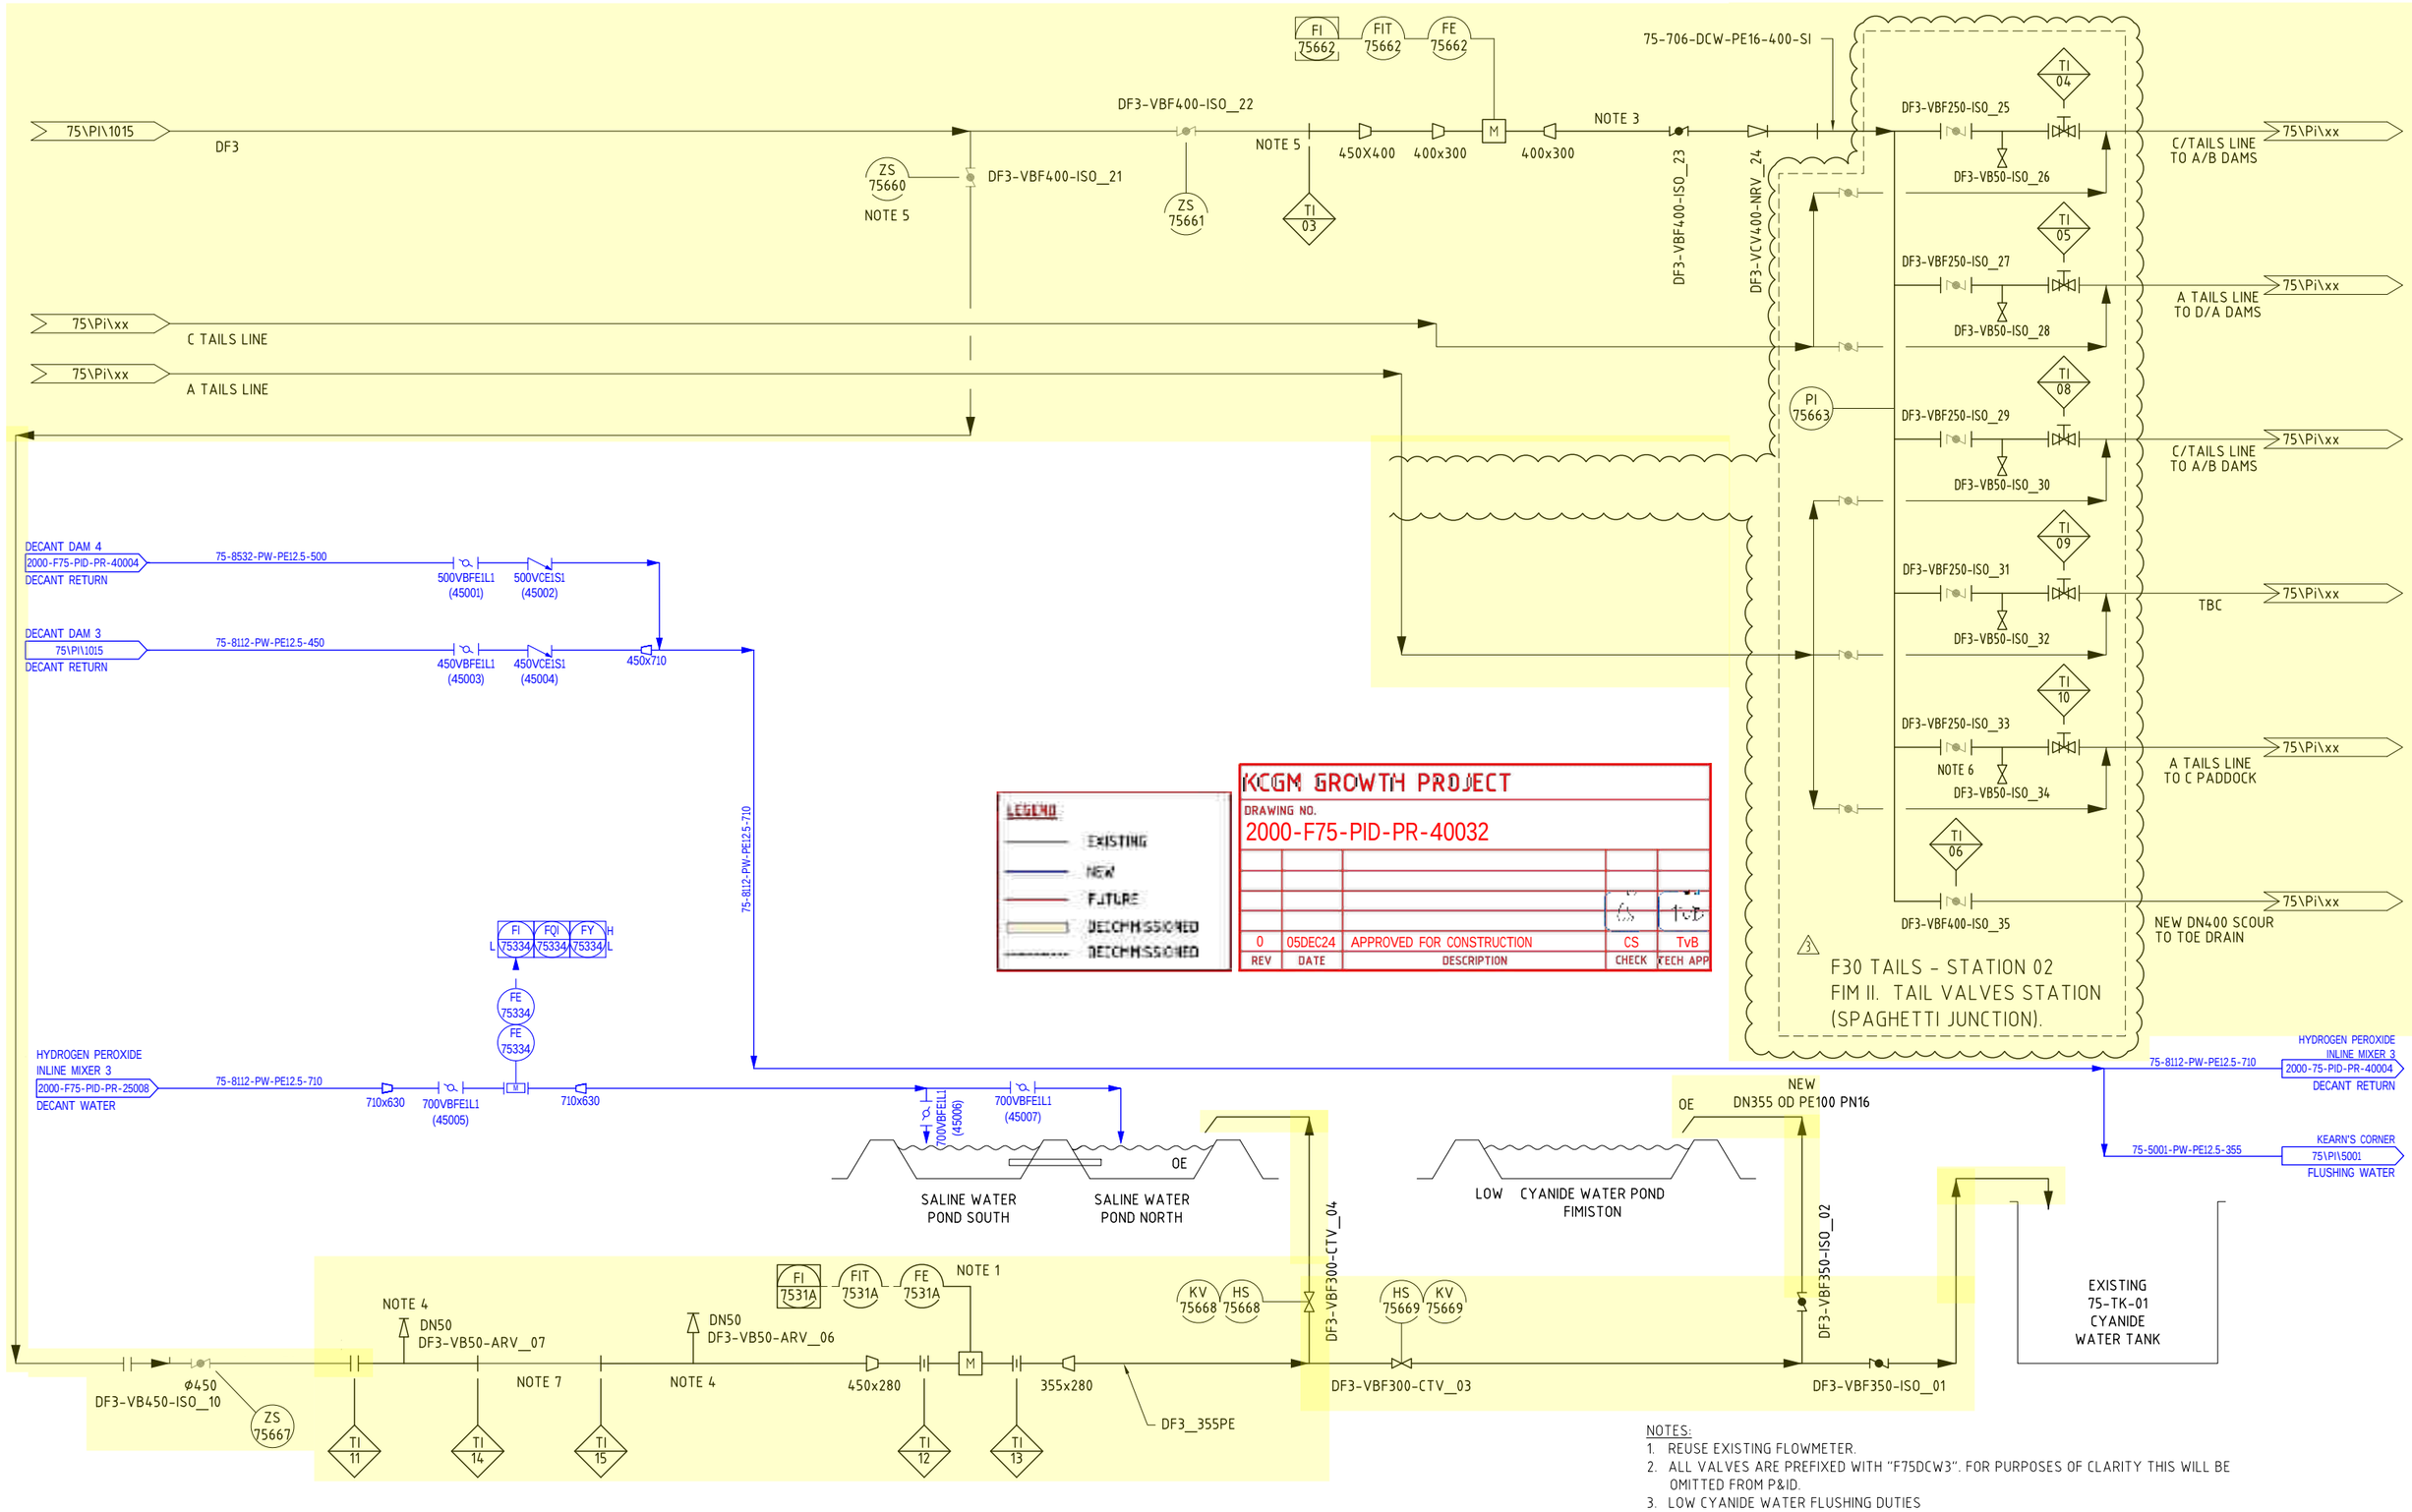

NOTES:
1. REUSE EXISTING FLOWMETER.
2. ALL VALVES ARE PREFIXED WITH "F75DCW3". FOR PURPOSES OF CLARITY THIS WILL BE OMITTED FROM P&ID.
3. LOW CYANIDE WATER FLUSHING DUTIES
4. VENT VALVE TO BE POSITIONED AT HIGH POINT SOUTH OF DAMS.
5. POSITIONERS TO BE ADDED TO MANUAL VALVES 450 F2KV01H & F2KV01G
6. EXISTING BUTTERFLY VALVES TO BE RESITED UPSTREAM OF NEW TIE PIECE & KNIFE GATE VALVE
7. REUSE EXISTING SECTION OF DN450 PN16 PE100 HDPE PIPE (BURIED).

MK	DATE	REVISION	BY	CKD	APP
3	12.05.2020	REVISED - 'AS BUILT'.	LW	T.R.	
2	07/07/17	FINAL AS BUILT	RH	JS	JS
1	28/06/17	AS BUILT	RH	JS	JS
0	2016-10-19	ISSUED FOR CONSTRUCTION	FAU	AB	JS

STANDARD DRAWING - STANDARD PIPING - ABBREVIATIONS, DRAWING NUMBERING & BASIC VALVE SYMBOLS
REFERENCE DRAWINGS
001\SP\1003
DWG NO.

SCALE	NTS	
DRAWN	PAZ	20/07/16
DESIGNED	A.B.	20/07/16
CHECKED		
APPROVED		
PROJ.APP		
PROJ. FILE #.	K417746	

FIMISTON PLANT
WATER TREATMENT FIMISTON KALTAILS
DECANT DAM 3 PUMP UPGRADE
PROCESS & INSTRUMENT DIAGRAM

SIZE	DRAWING NUMBER	REV
A1	75\Pi\1016	3

KALGOORLIE CONSOLIDATED GOLD MINES PTY. LTD. ABN 009 377 619 003